


WAKEMAN - LAGRANGE - RICHFIELD

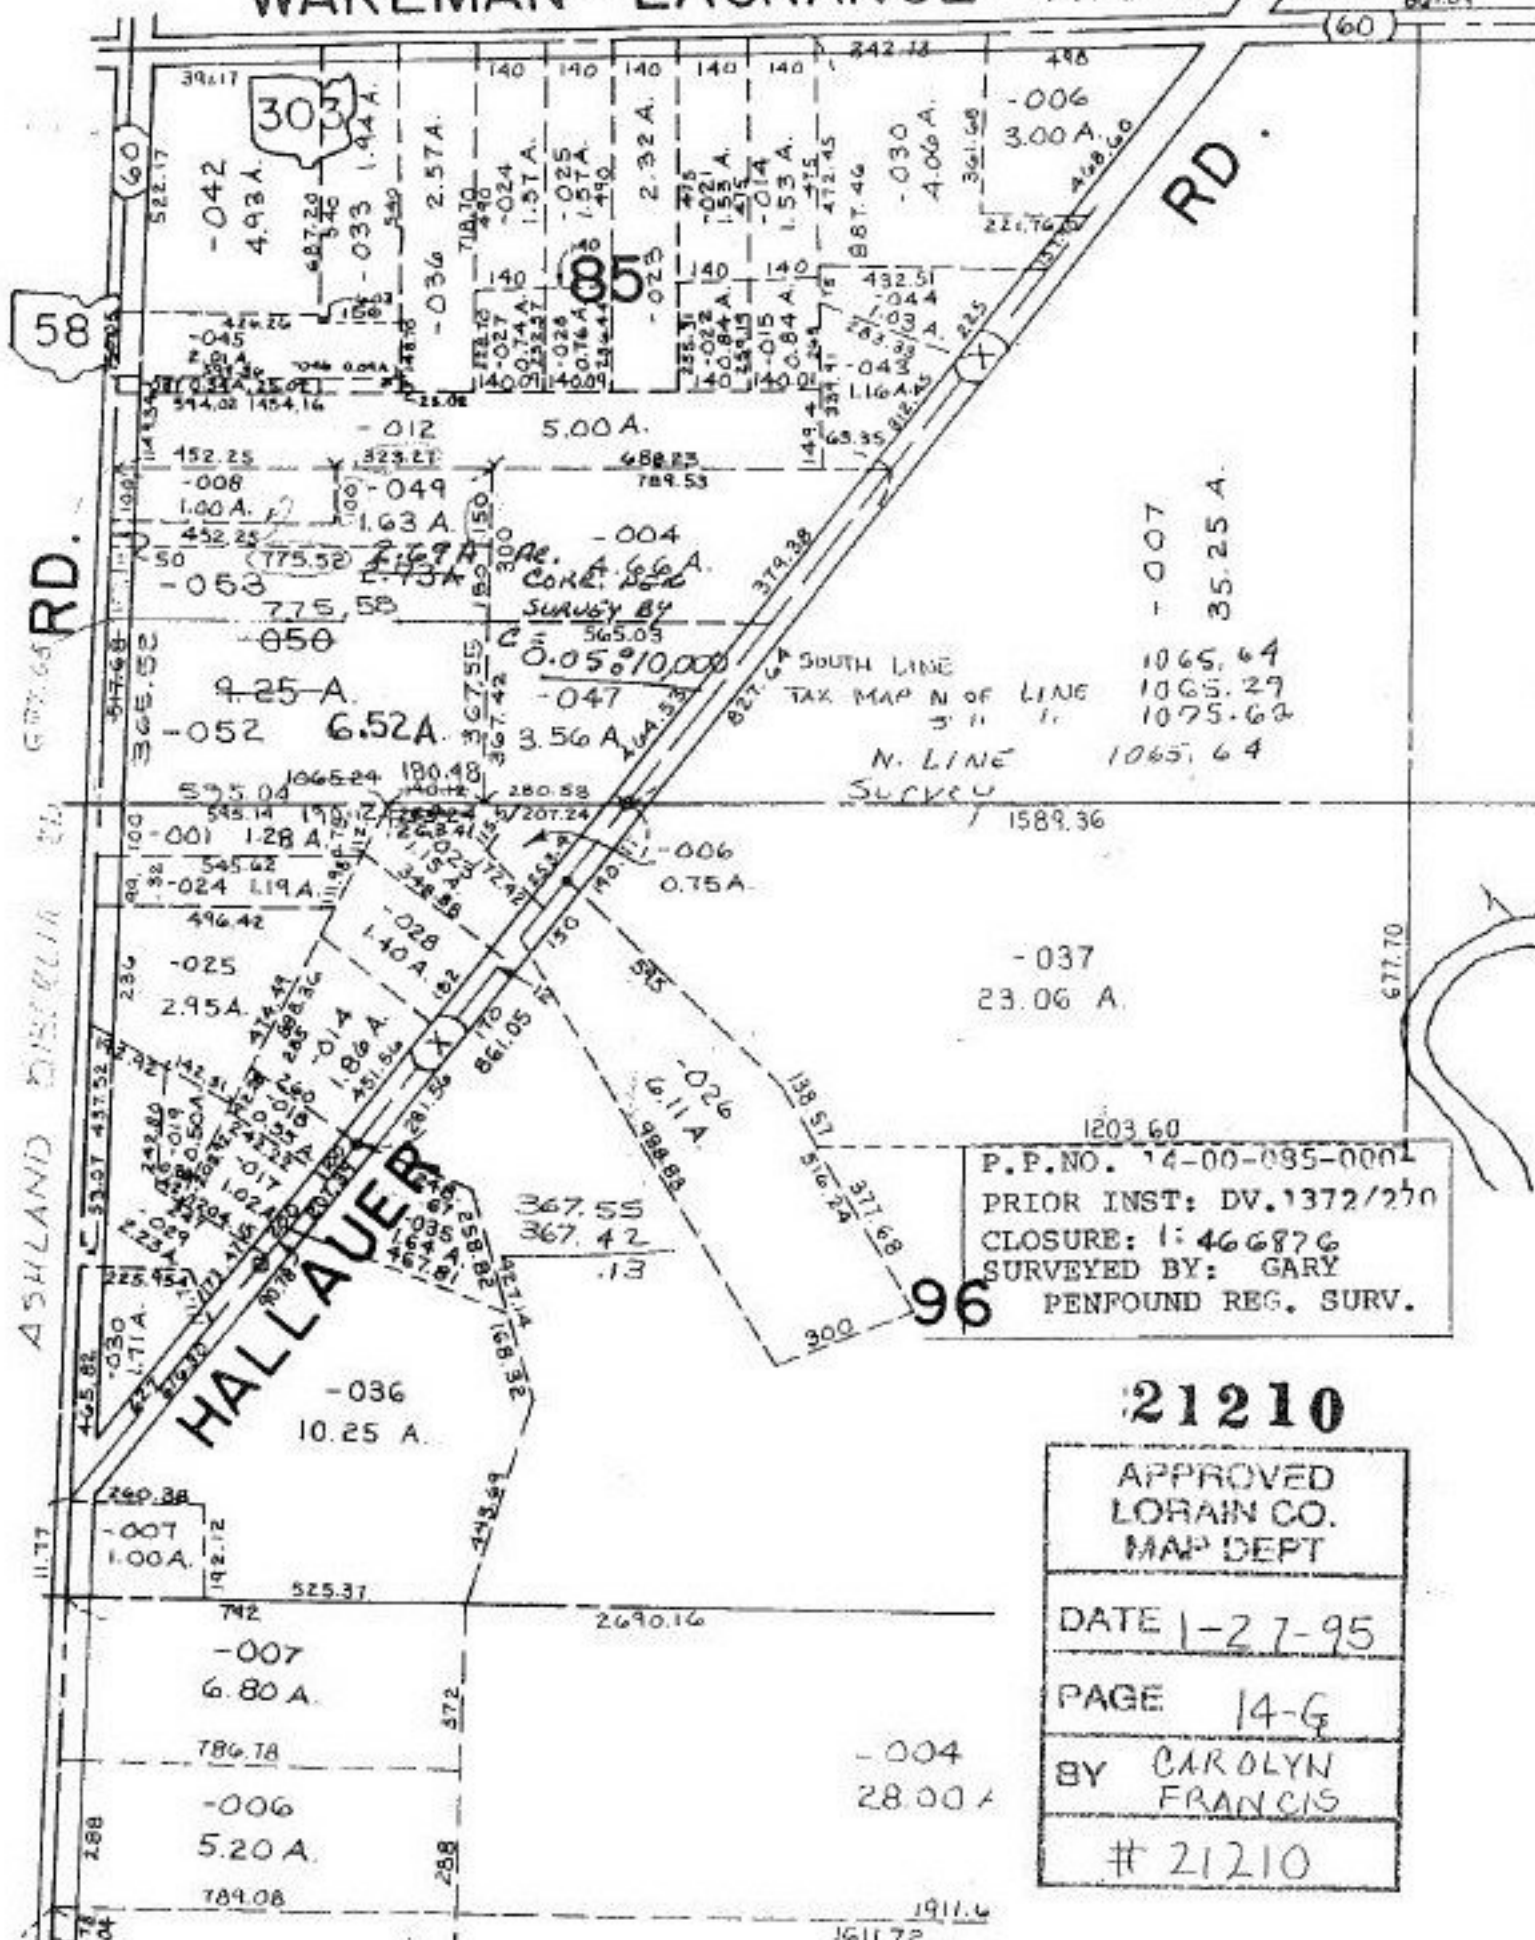

P.P. NO. 14-00-035-0001
 PRIOR INST: DV. 1372/270
 CLOSURE: 1:46 6876
 SURVEYED BY: GARY
 PENPOUND REG. SURV.

21210

APPROVED LORAIN CO. MAP DEPT
DATE 1-27-95
PAGE 14-G
BY CAROLYN FRANCIS
21210