
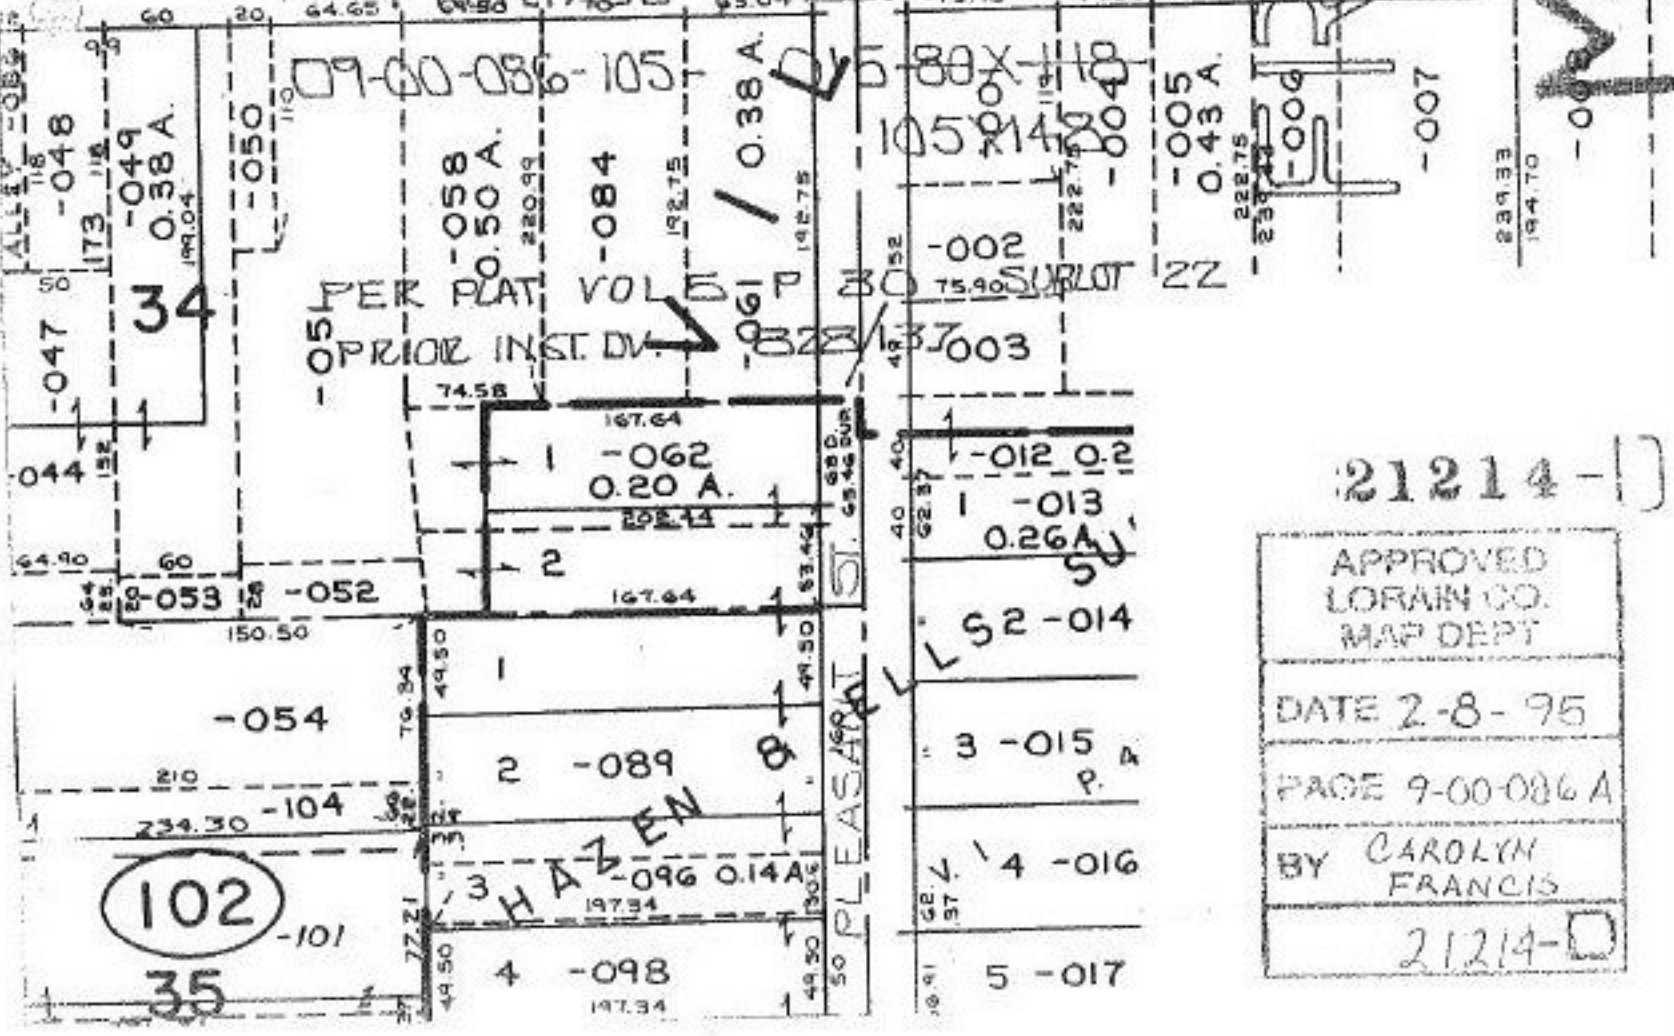


VOL. 2/50  
1/20  
6

21214-30

101

105

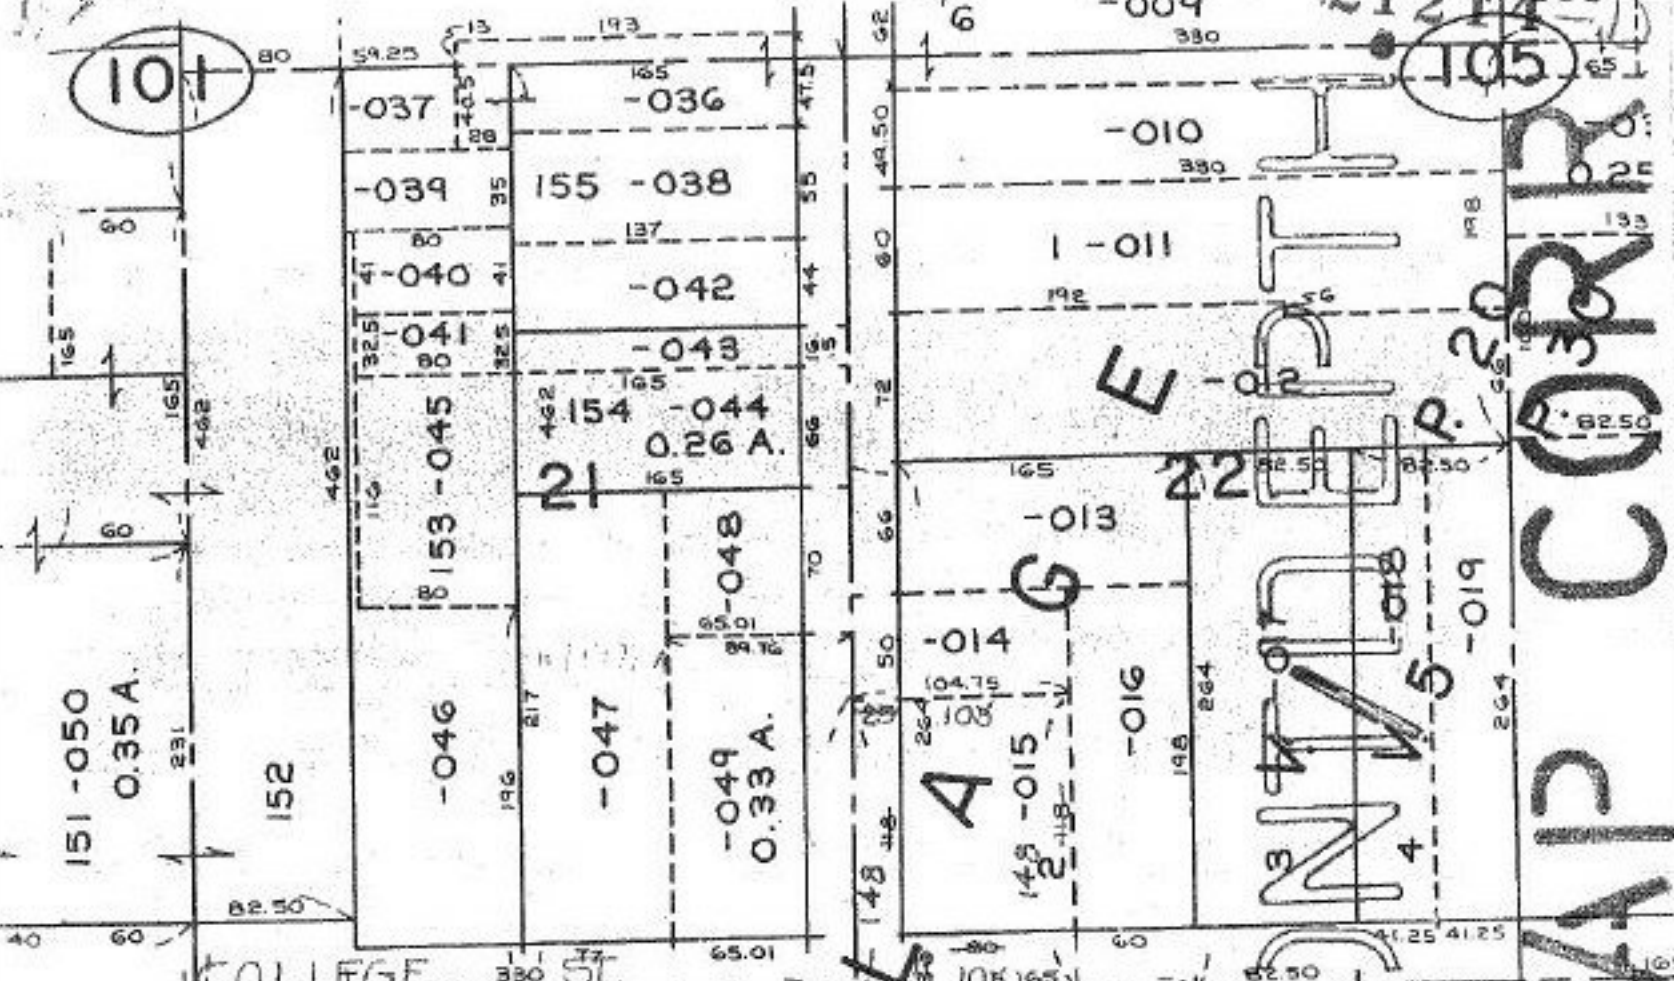

COLLEGE ST. FRONTAGE DEPTH CORR

PER PLAT VOL 5  
OPRIOR INST. DV. 322/337

