


#21215X

**NO CHANGES
OF TAX MAP**

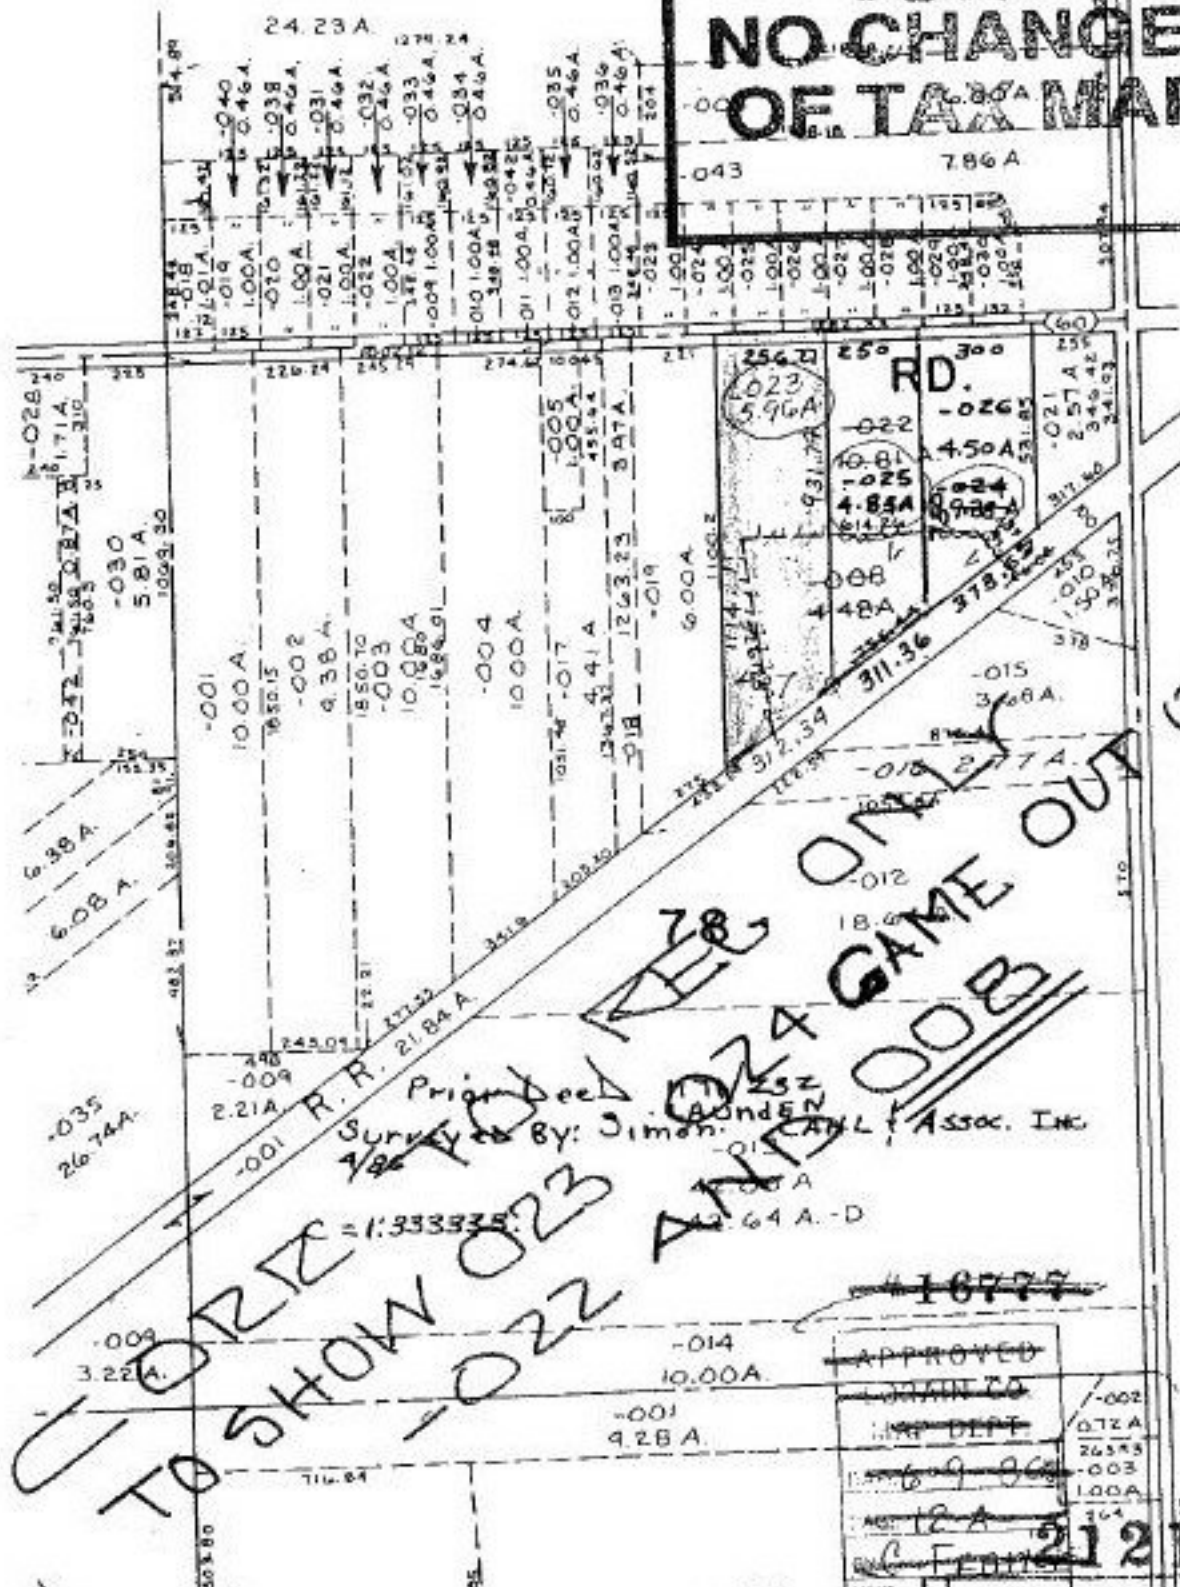

TO SHOW 023 AND 008

REQ ONLY GAME OUT OF

-008 4.48A
 022 10.81A
15.29A
TOTAL =

15.29A
 596A 023
9.33A 024

~~416777~~

APPROVED	-002
JOHN CO	072A
DEPT	26543
6-9-95	-003
12A	100A
FEEDS	364
VOID AT THE	21215-X
APPROVED	LORAIN CO.
DEPT	SPILT
2-8-95	
DATE PUT IN	PAGE 12-A
REGISTER	BY CAROLYN FRANCIS
	21215-X