


#21217-D

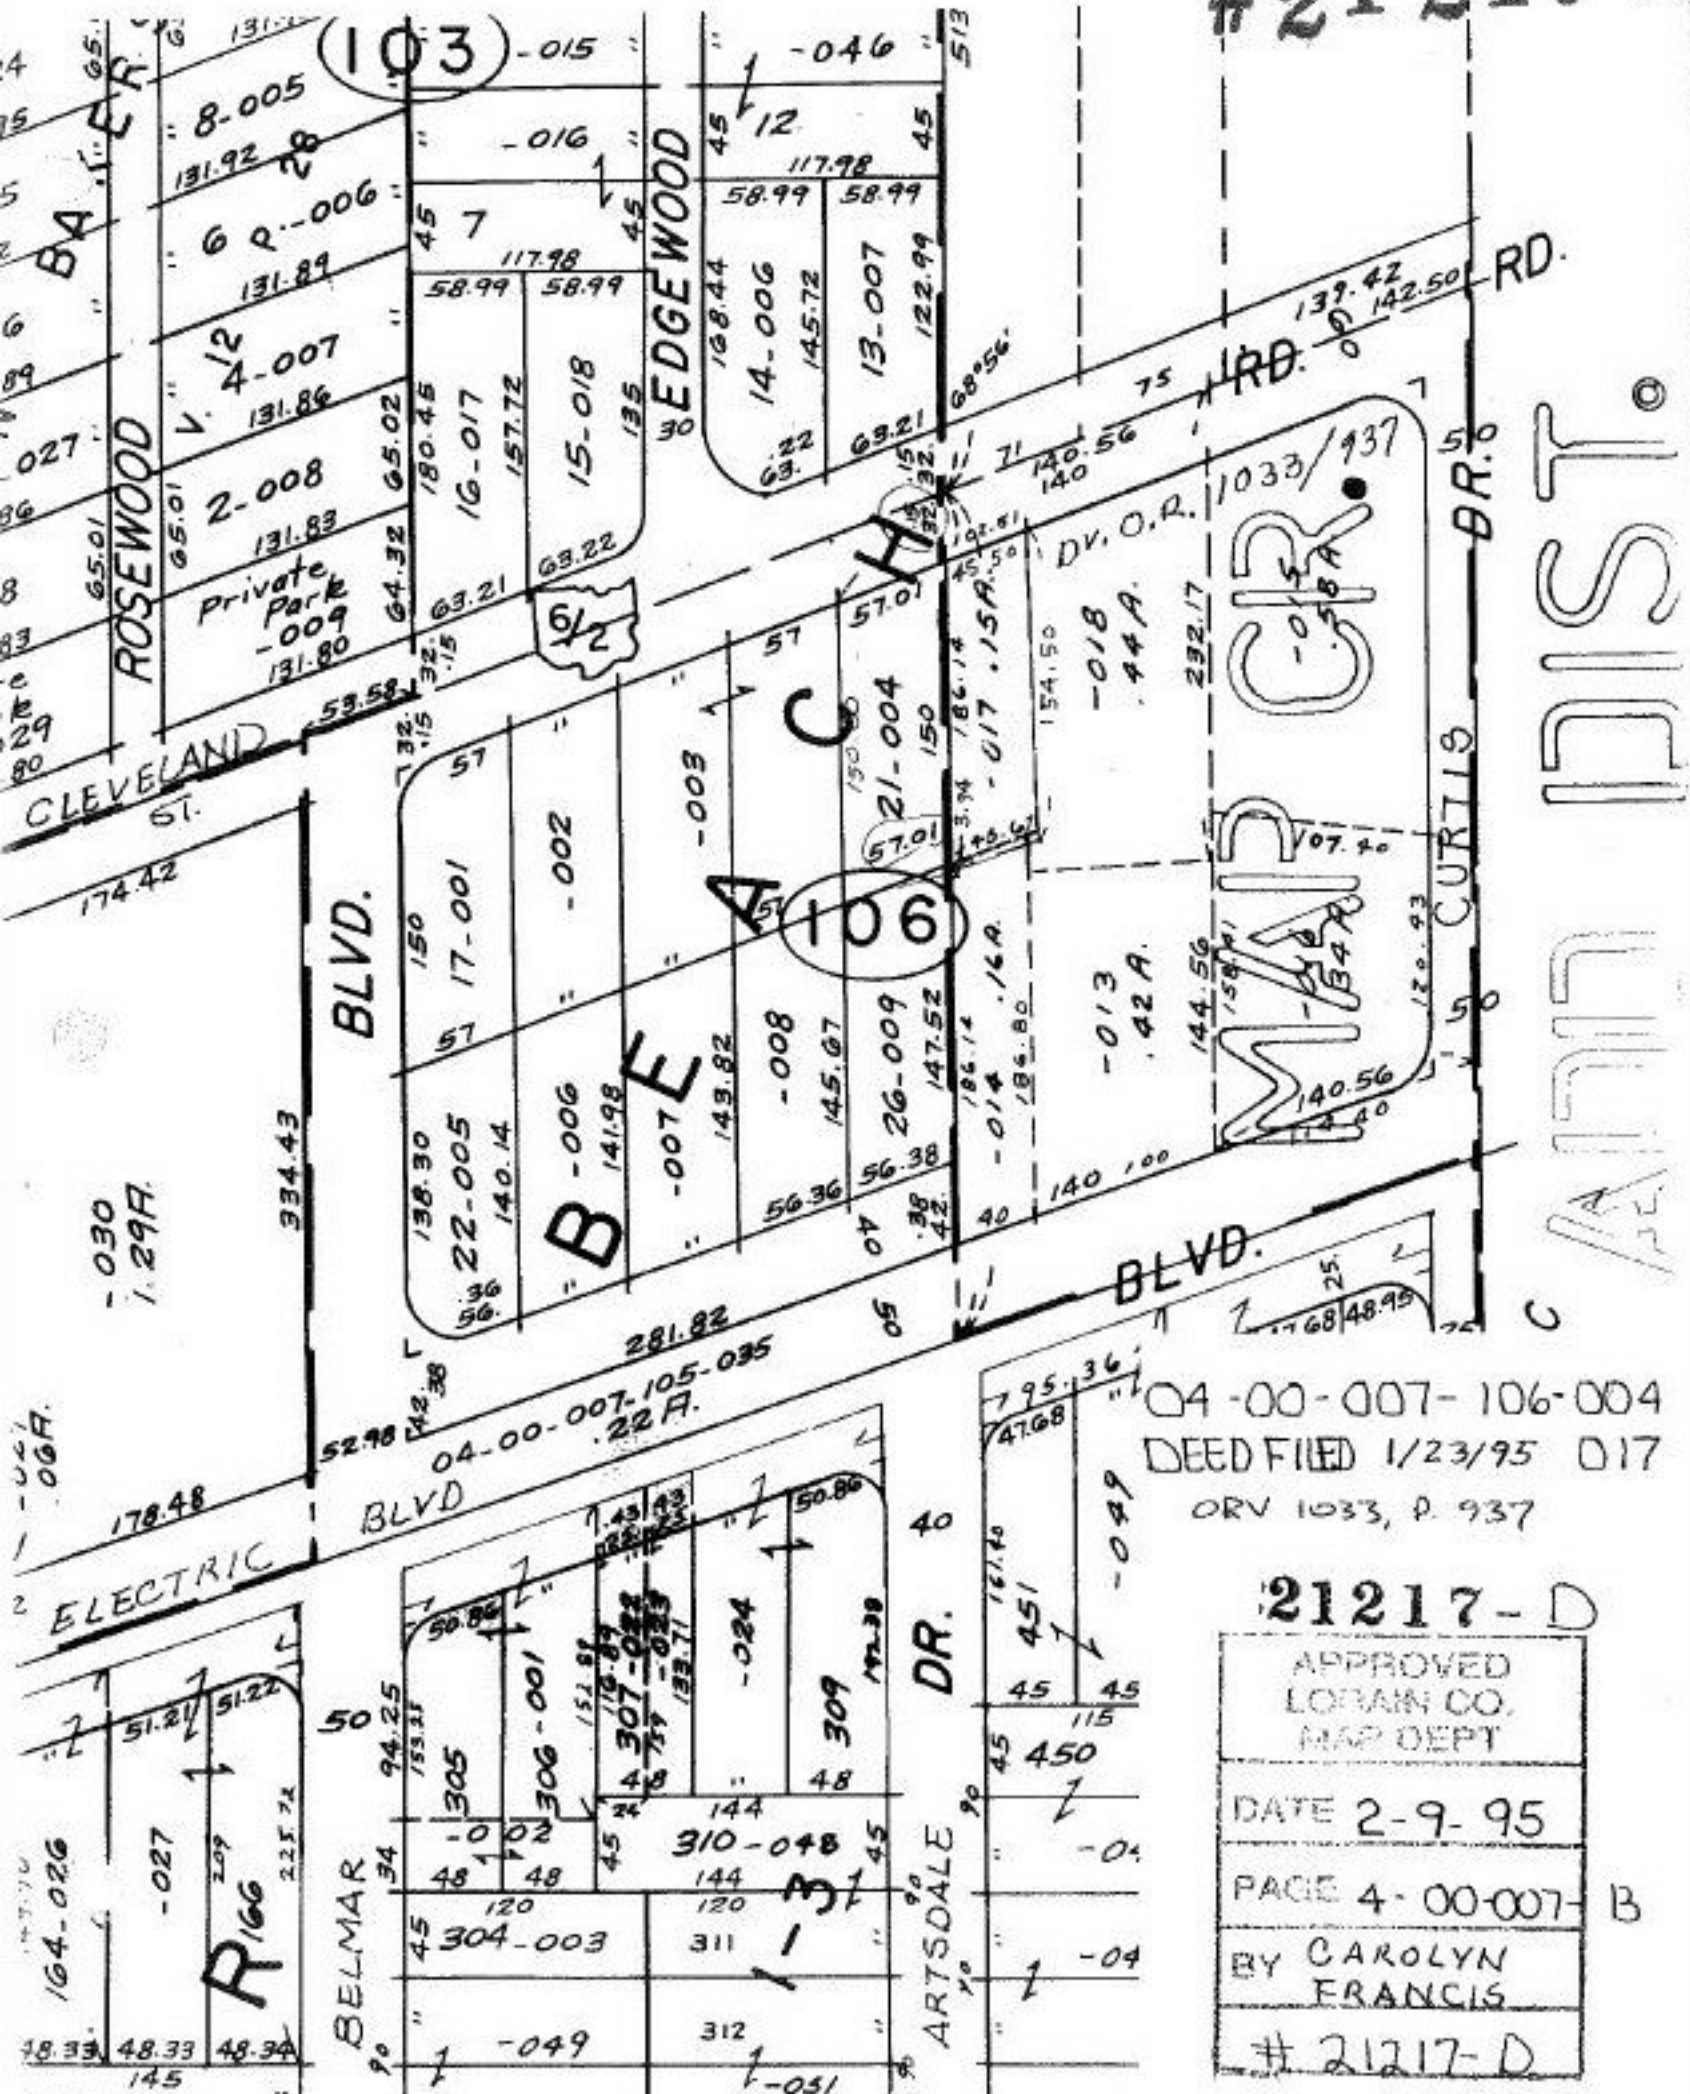

04-00-007-106-004
 DEED FILED 1/23/95 017
 ORV 1033, P. 937

21217-D

APPROVED LORAIN CO. MAP DEPT
DATE 2-9-95
PAGE 4-00-007-B
BY CAROLYN FRANCIS
21217-D