


SEE 7-H

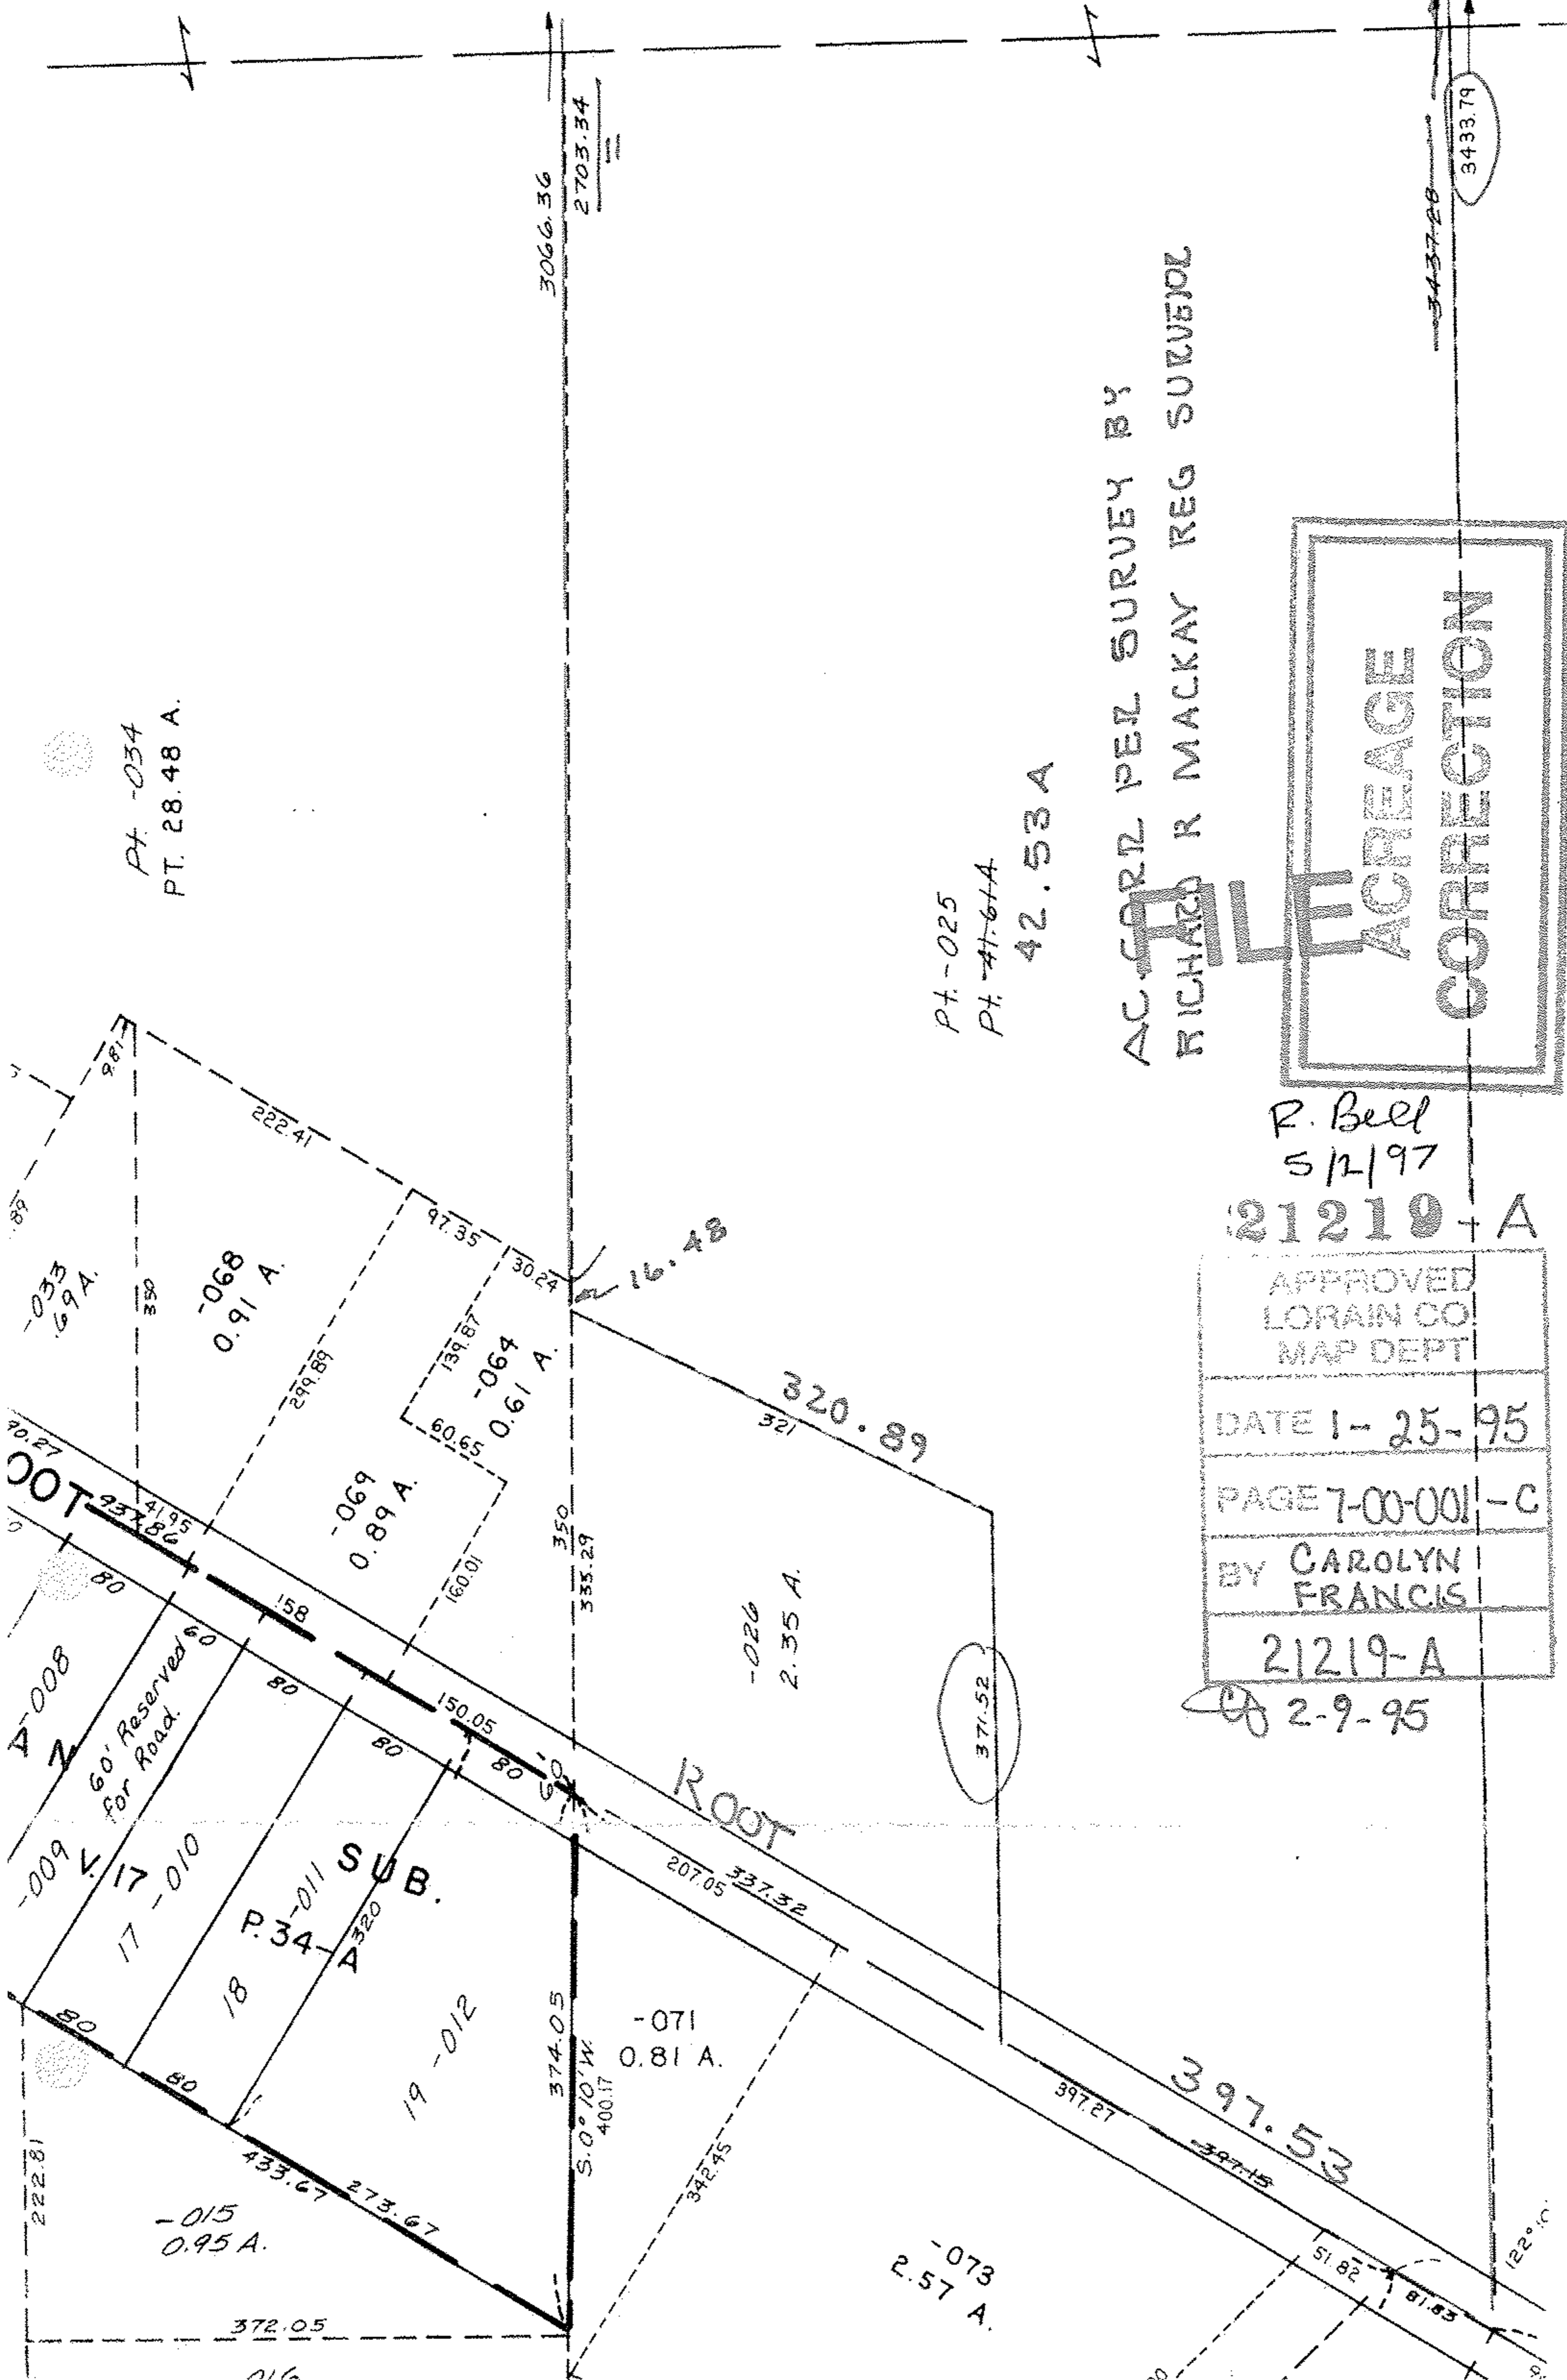

PT. -034
PT. 28.48 A.

PT. -025
PT. 47.64 A.

42.53 A

AC. CORR. PER SURVEY BY
RICHARD R MACKAY REG SURVEYOR

ACREAGE
CORRECTION

R. Bell
5/12/97

21219-A

APPROVED LORAIN CO. MAP DEPT
DATE 1-25-95
PAGE 7-00-001-C
BY CAROLYN FRANCIS
21219-A

2-9-95