


#21221-X


-018
10.25 A. - Dup.
11.85 A. - Pl.

019 3.85 A
068 1.24 A
062 1.69 A
6.78 A

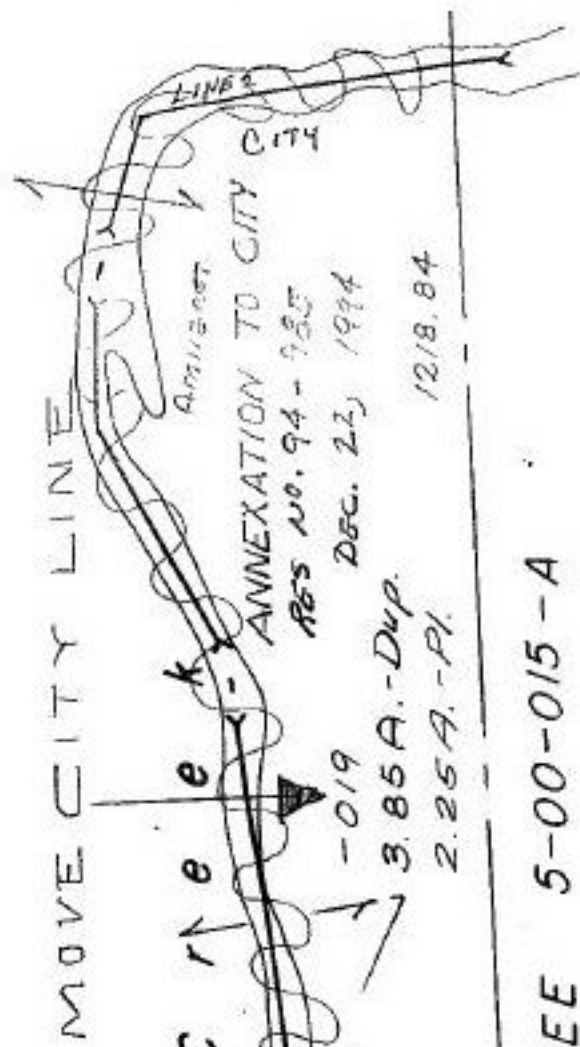

SEE 5-00-015-A

ANNEX TO:
CITY OF AMHERST

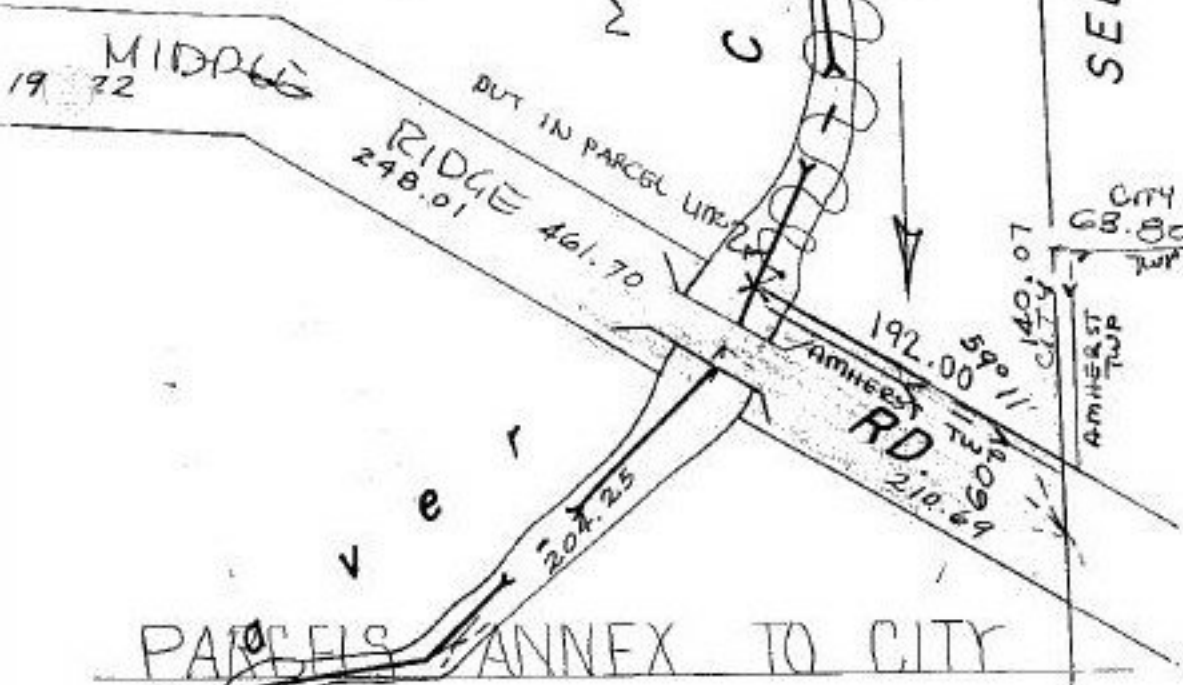

21221-X

05-00-006-000-019
05-00-015-000-068
05-00-015-000-062

| |
|------------------------------------|
| APPROVED LORAIN CO. MAP DEPT |
| DATE 3-6-95 |
| PAGE 5-00-006B |
| BY CAROLYN FRANCIS |
| 21221-X |

-023



8.12