

105

1.70 F.

ER-530

ER-530

1.002
70 F.

330

DETAIL


MAP CORR TO:
FRONTAGE CORR.
03-00-049-110-001

PER PLAT VOL 15 PG. 7 SL 352



21224-X

APPROVED LORAIN CO. MAP DEPT
DATE 2-16-95
PAGE 3-00-049-A
BY CAROLYN FRANCIS
21224-X

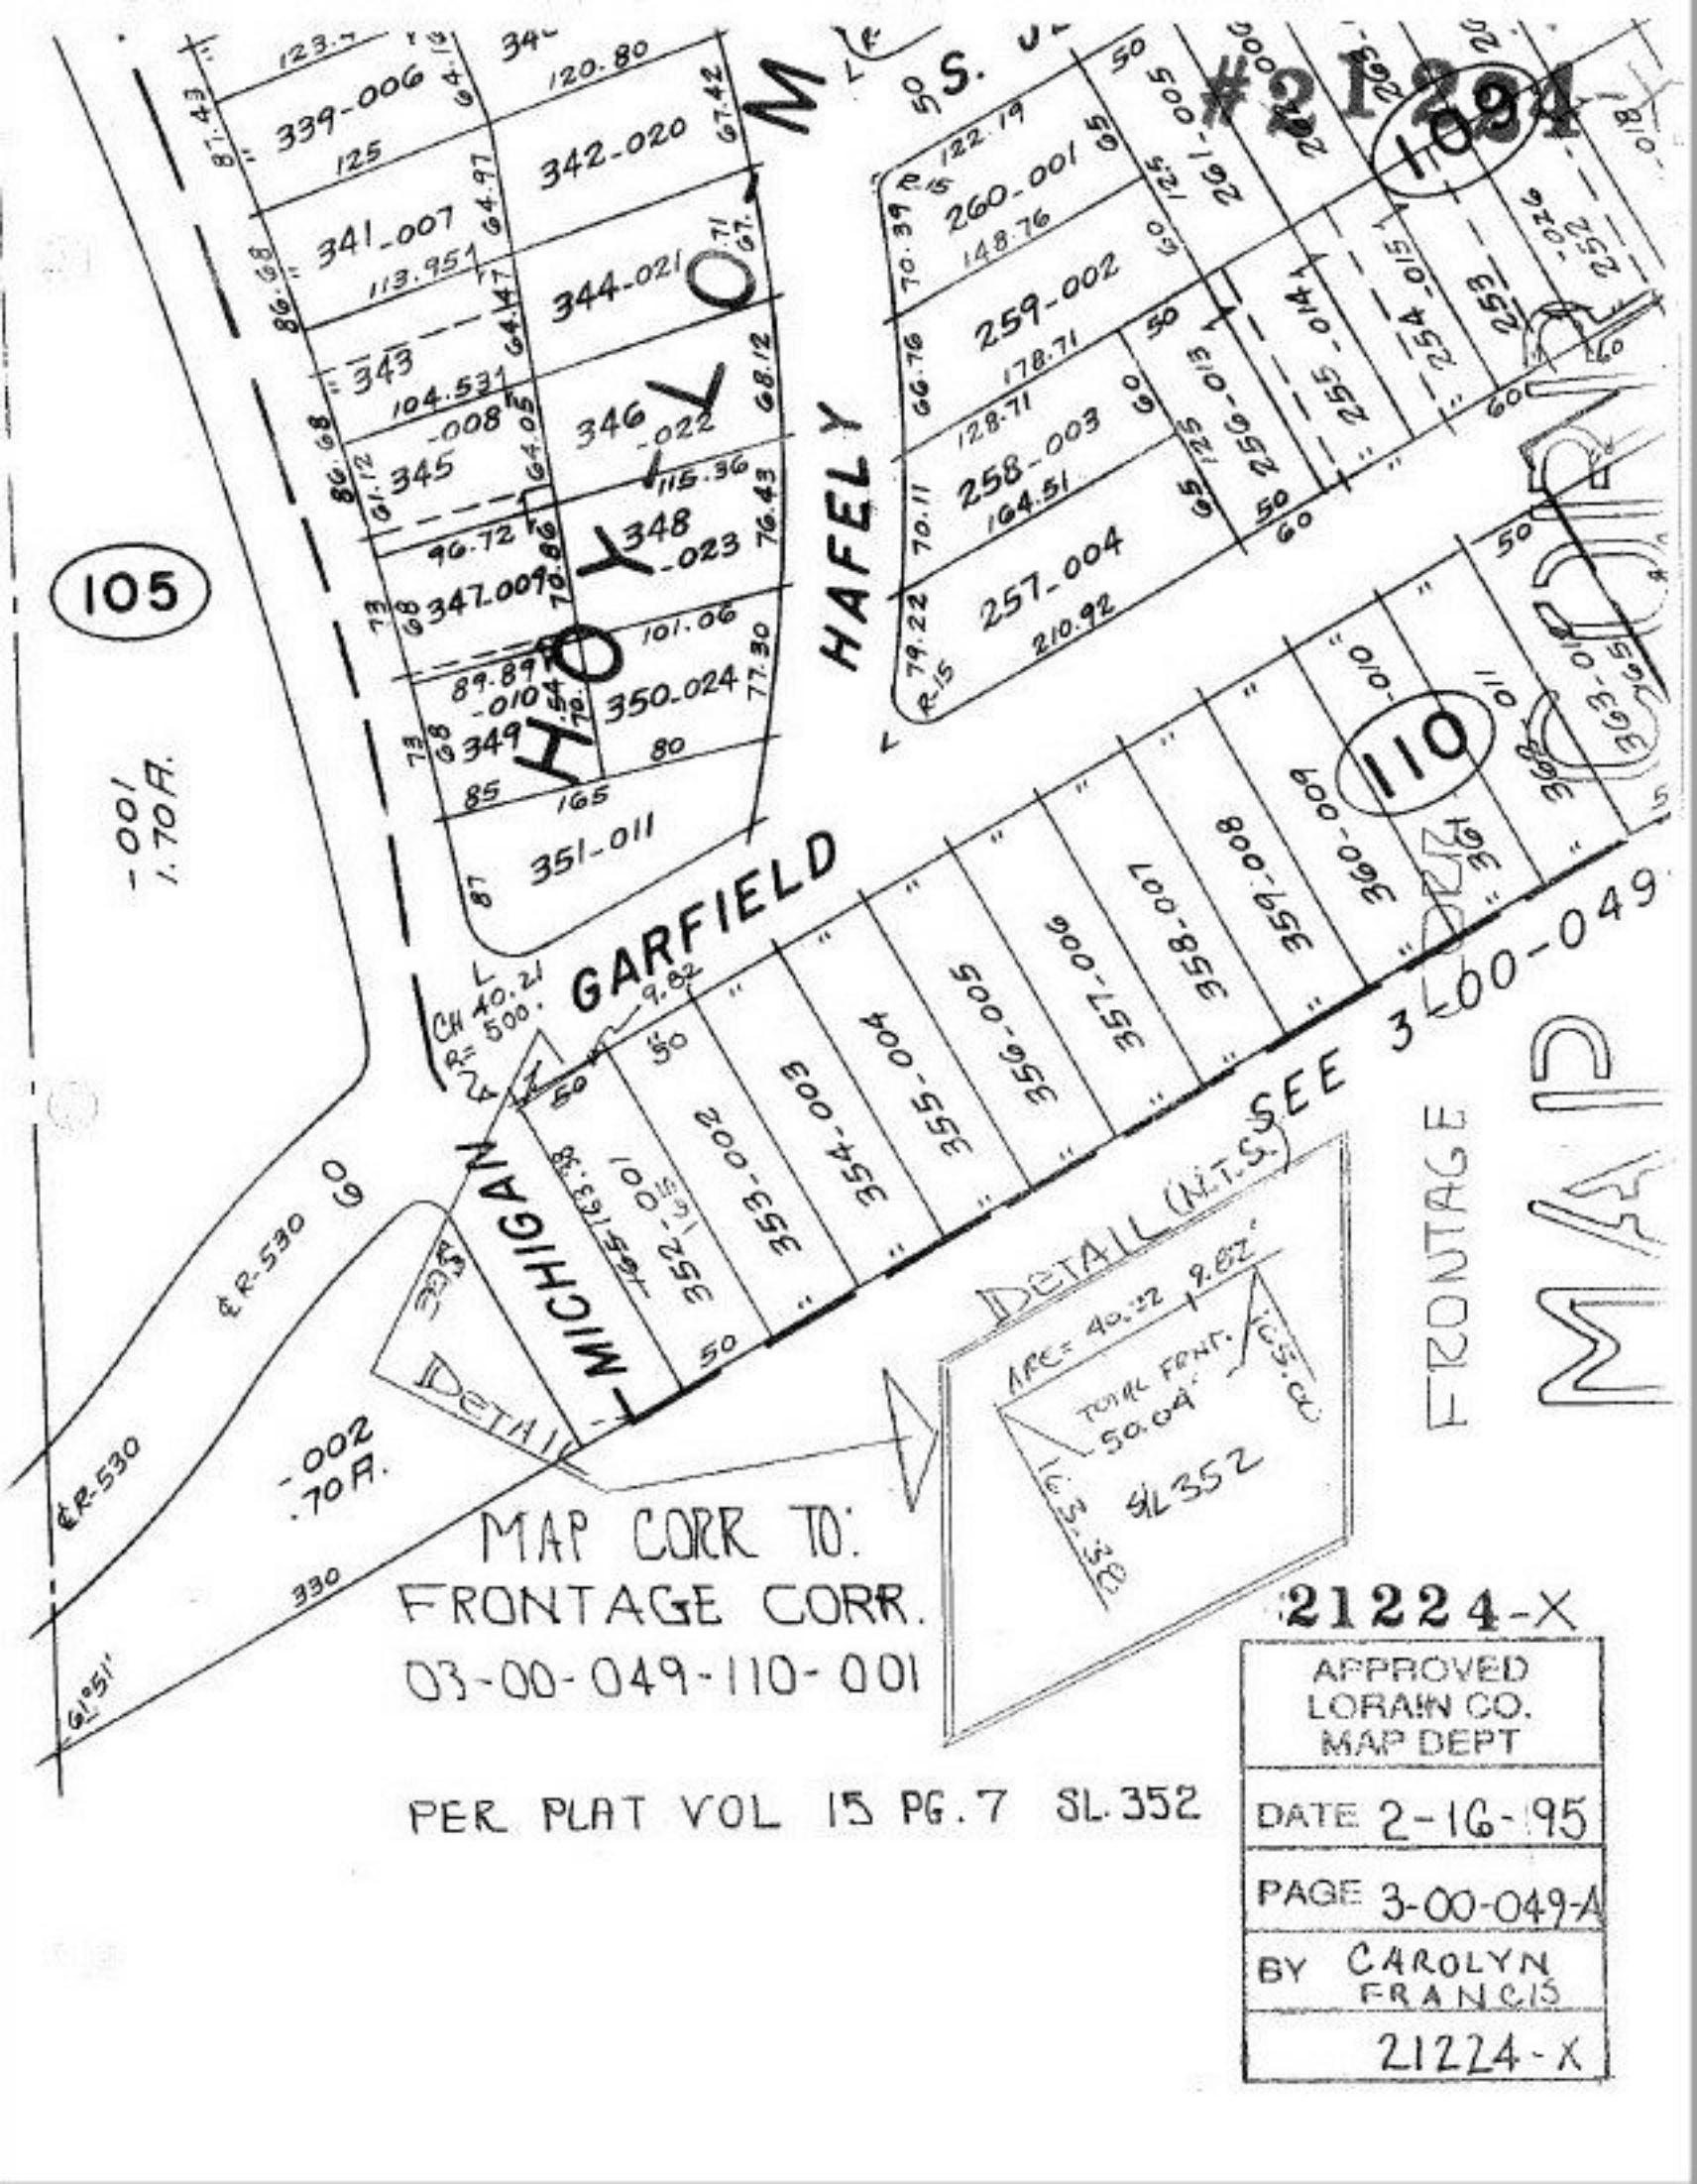

FRONTAGE
MAP