

1087.68 FROM IRON PIN LOCATED IN N.W.C. OF O.L. 26

1598.55

1598.55

~~564.66~~

1928.82

2127.82

330.05

(3)

Comb. - ~~016-0009 A.~~  
012-17.36 A.  
049-7.62 A.

Pt. 07-00

Pt. 07-00-026-102-020  
Pt. 24.98 A.

~~016-0009 A.~~  
Pt. 24.98 A - DEED  
24.98

COMBINATION


975.63

1569.25

564.89

9.74 A  
7.62 A  
2.12 A

COMBINATION

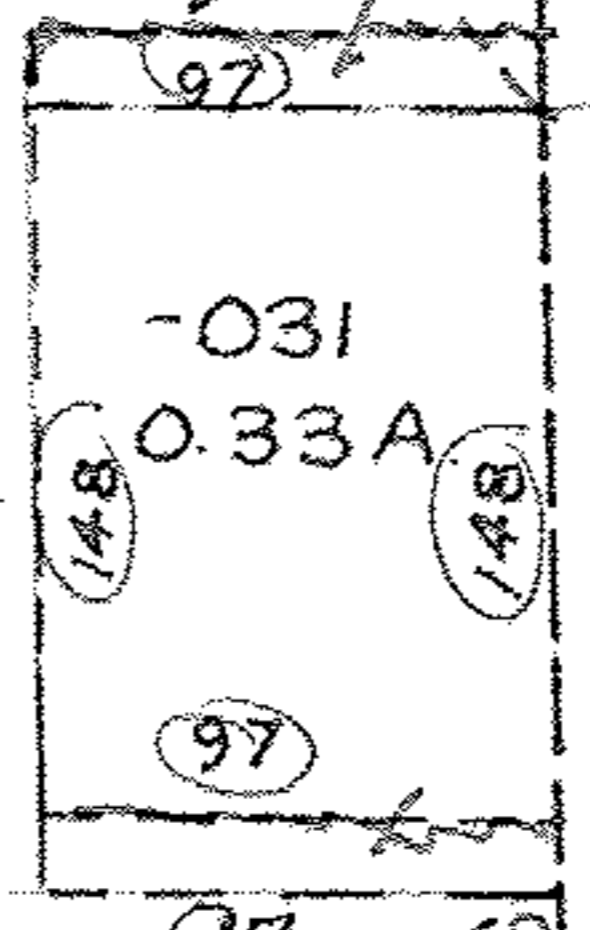

P.P. NO 07-00-026-102-  
07-00-026-104-  
PRIOR INST: 188-049)  
107-00-026-102-012  
DV. 408/1174  
027  
4.62 A

~~049~~

Pt. -048  
Pt. 9.74 A.  
2.62 A

390.  
EXTENSION OF CENTER  
OF WESTFIELD DR.

21227

APPROVED  
LORAIN CO.  
MAP DEPT

DATE 2-6-95

PAGE 7-00-026

BY CAROLYN  
FRANCIS

330.05 21227

330.04

330.04

5-12-95

569.95

(3)