

7-0


SEE

1545

270.23

460.54

319.57

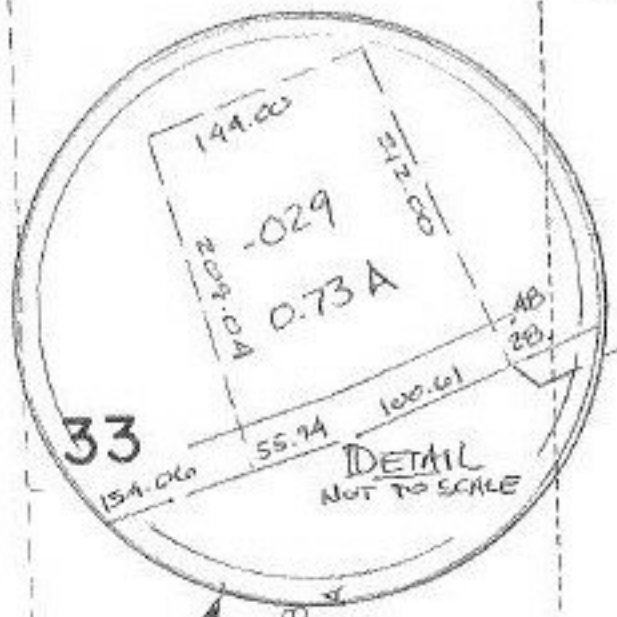

-003  
99.75 A

CH. IN P.B.  
430. TO: 480.76

-030  
-027  
38.55 A  
37.82 A


OVER ALL DIST. 559.09 TAX MAP  
PLACE OF Bg. 469.24  
99.85  
100.61

.76 FEET DIFFERENT  
PLACE OF BEGINNING  
CH TO. 430.76

~~MAJORITY~~

430.76  
129.09  
559.85 R/W  
TO ANGLE POINT.

413.16  
2279.6  
166.16

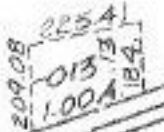

CENTER RIDGE SEE  
MAY 15-12-95  
21230

APPROVED  
LORAIN CO.  
MAP DEPT.

DATE 2-13-95

SEE 7-F  
PAGE 7-B

BY CAROLYN  
FRANCIS

# 21230



P.P. NO. 07-00-033-000  
PRIOR INST: DR. 156/170  
CLOSURE: 1:191,374  
SURVEYED BY: DANE A. HAPONEK  
REG. SURVEYOR

MADDOCK RD.