



#21252-D

-002
46.50 A.

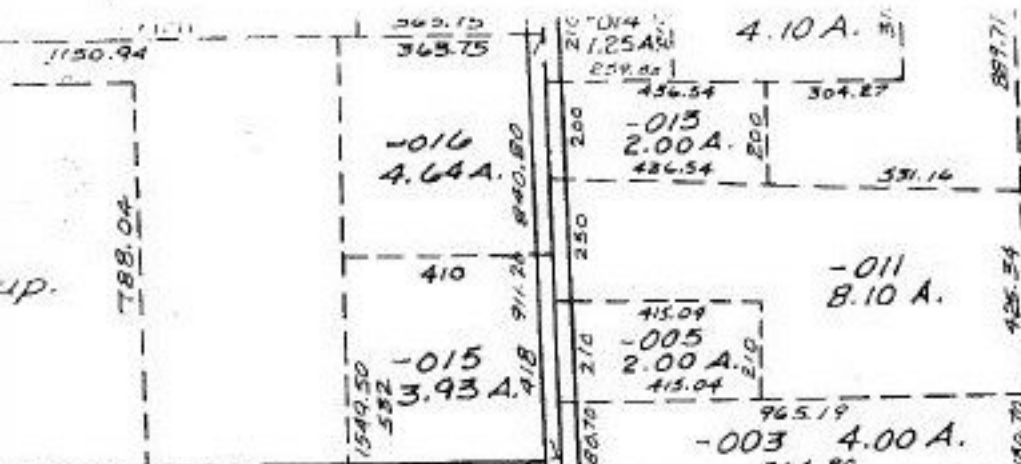


MAP CORR. ONLY

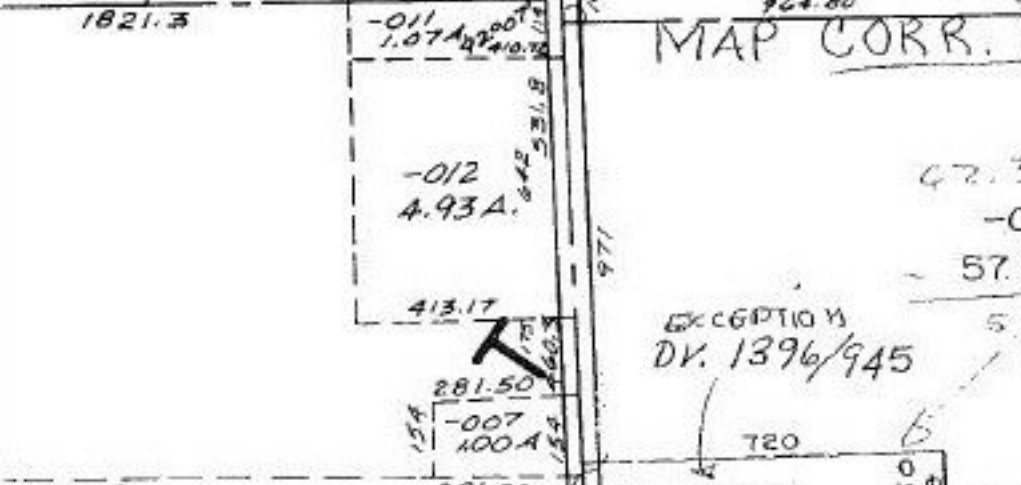

EXCEPTION
DV. 1396/945

47.30
-005
57.30 A. PARCEL #2
5.00

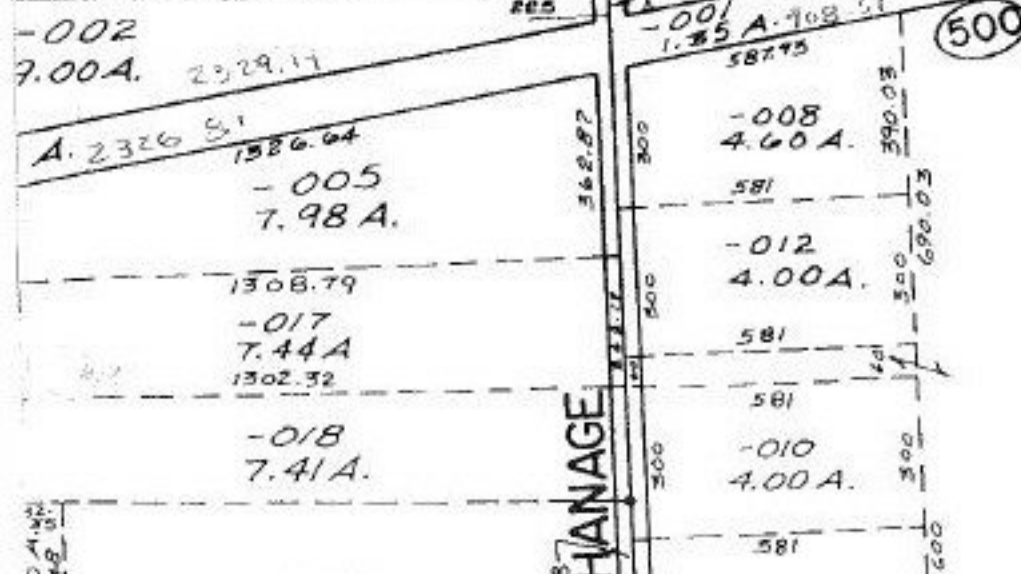

HANAGE

MAP CORR

500

21252-D

APPROVED LORAIN CO. MAP DEPT
DATE 2-28-95
PAGE 13-A
BY CAROLYN FRANCIS
21252-D