


MERRIAM

21267

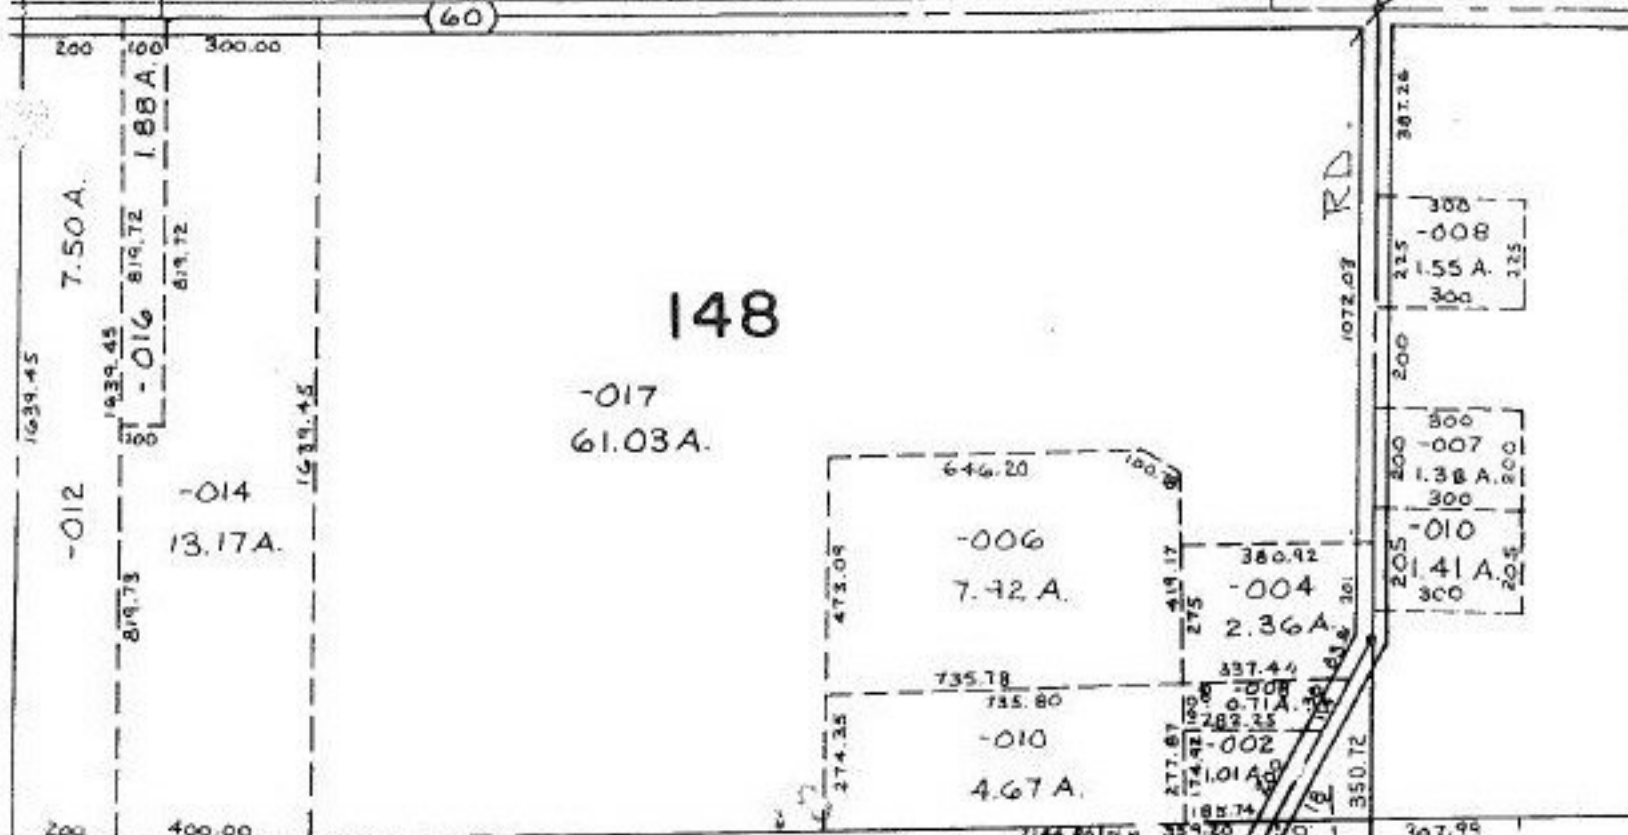

SPLIT: Comb:
 69.37 A 015 1.13A
 1.29 A 020 1.29A
 68.08 A 7.42A
 AC. PER -022 2.43A
 SURVEY BY KSA. C=0:02:10,000

COMB. 14-00-153-000-015
~~-020~~
 INTO: 14-00-153-000-022

153
 -021
 -016
 69.37A.
 68.08A.

P.P. NO. 14-00-153-000-
 PRIOR INST: O.R. 671/635
 DV. 1301/127
 CLOSURE: 1.29ac. 0.02:10,000
 2.43ac. 0.02:10,000
 SURVEYED BY: KSA
 MICHAEL A. STRAUB PS
 K.S. Assoc.
 PROFESSIONAL SURVEYORS



21267

APPROVED LORAIN CO. MAP DEPT
DATE 3-16-95
PAGE 14 F
BY CAROLYN FRANCIS
21267

SEE 18

PITTSFI

