


FILE

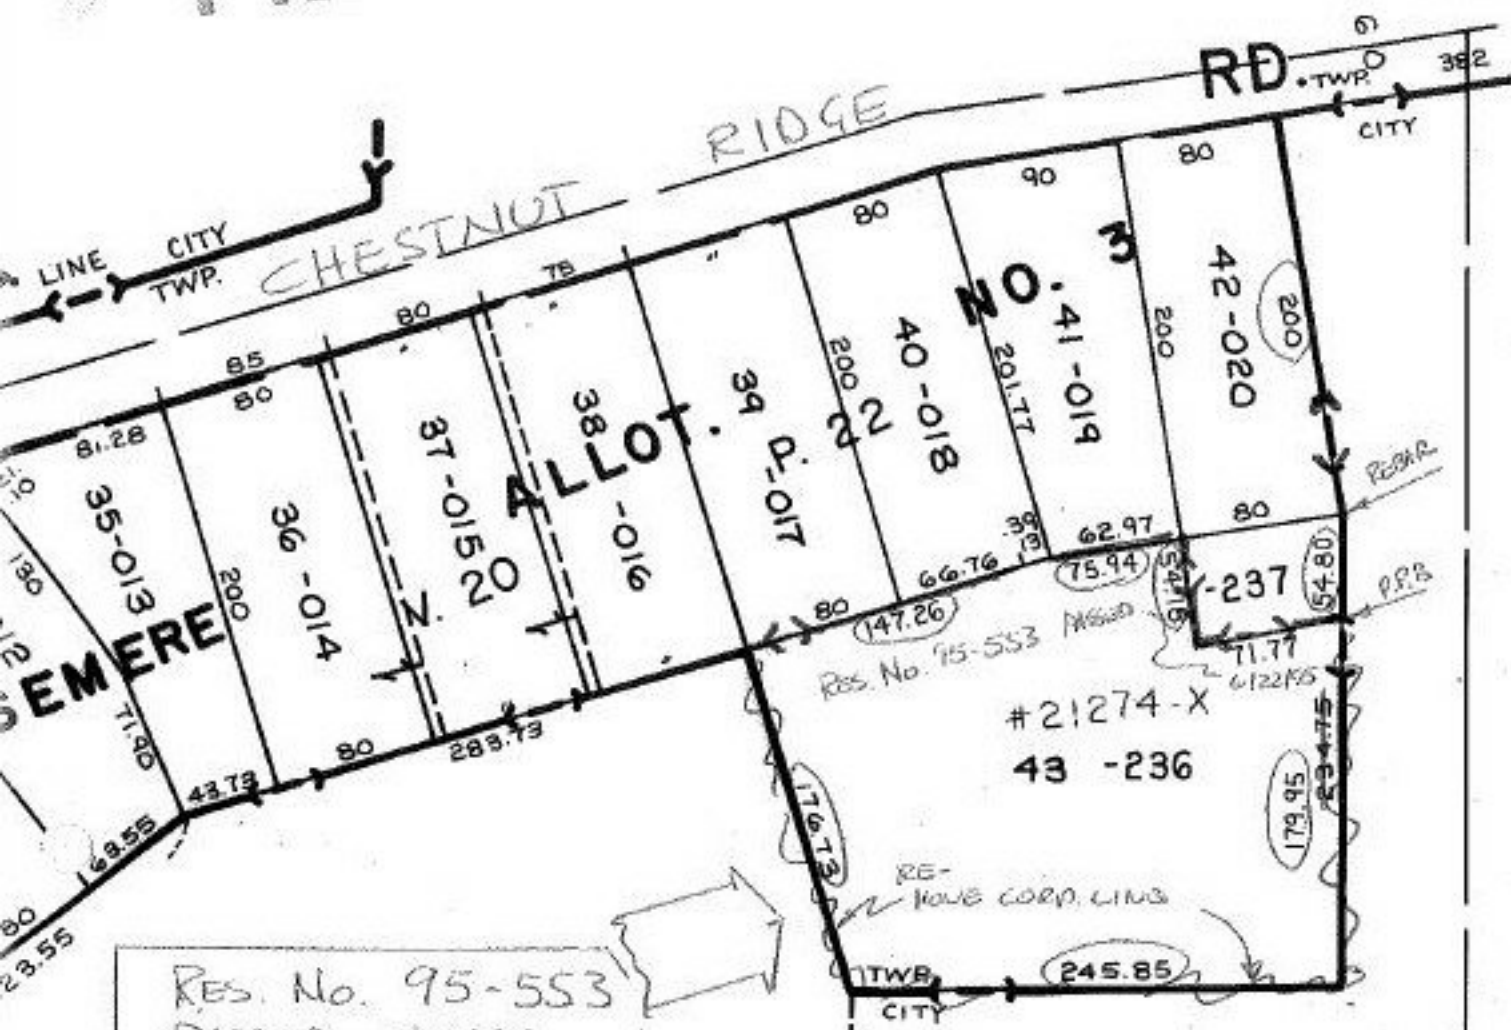

RES. No. 95-553
 PASSED 6/22/95

107

EFFECTIVE MS
 7-15-97

#21274-X

APPROVED LORAIN CO. MAP DEPT.	
DATE	3/13/96
PLAT	10-00-005-E
BY	T. McLean
VOID AFTER	21274-X

ANNEXATION

Pt. - 140
 Pt. 15.00 A.