


#21275-A

APPROVED LORAIN CO. SURV. NO.

Vol 50 Pgs 4, 44

101

SEE 5-00-098-C

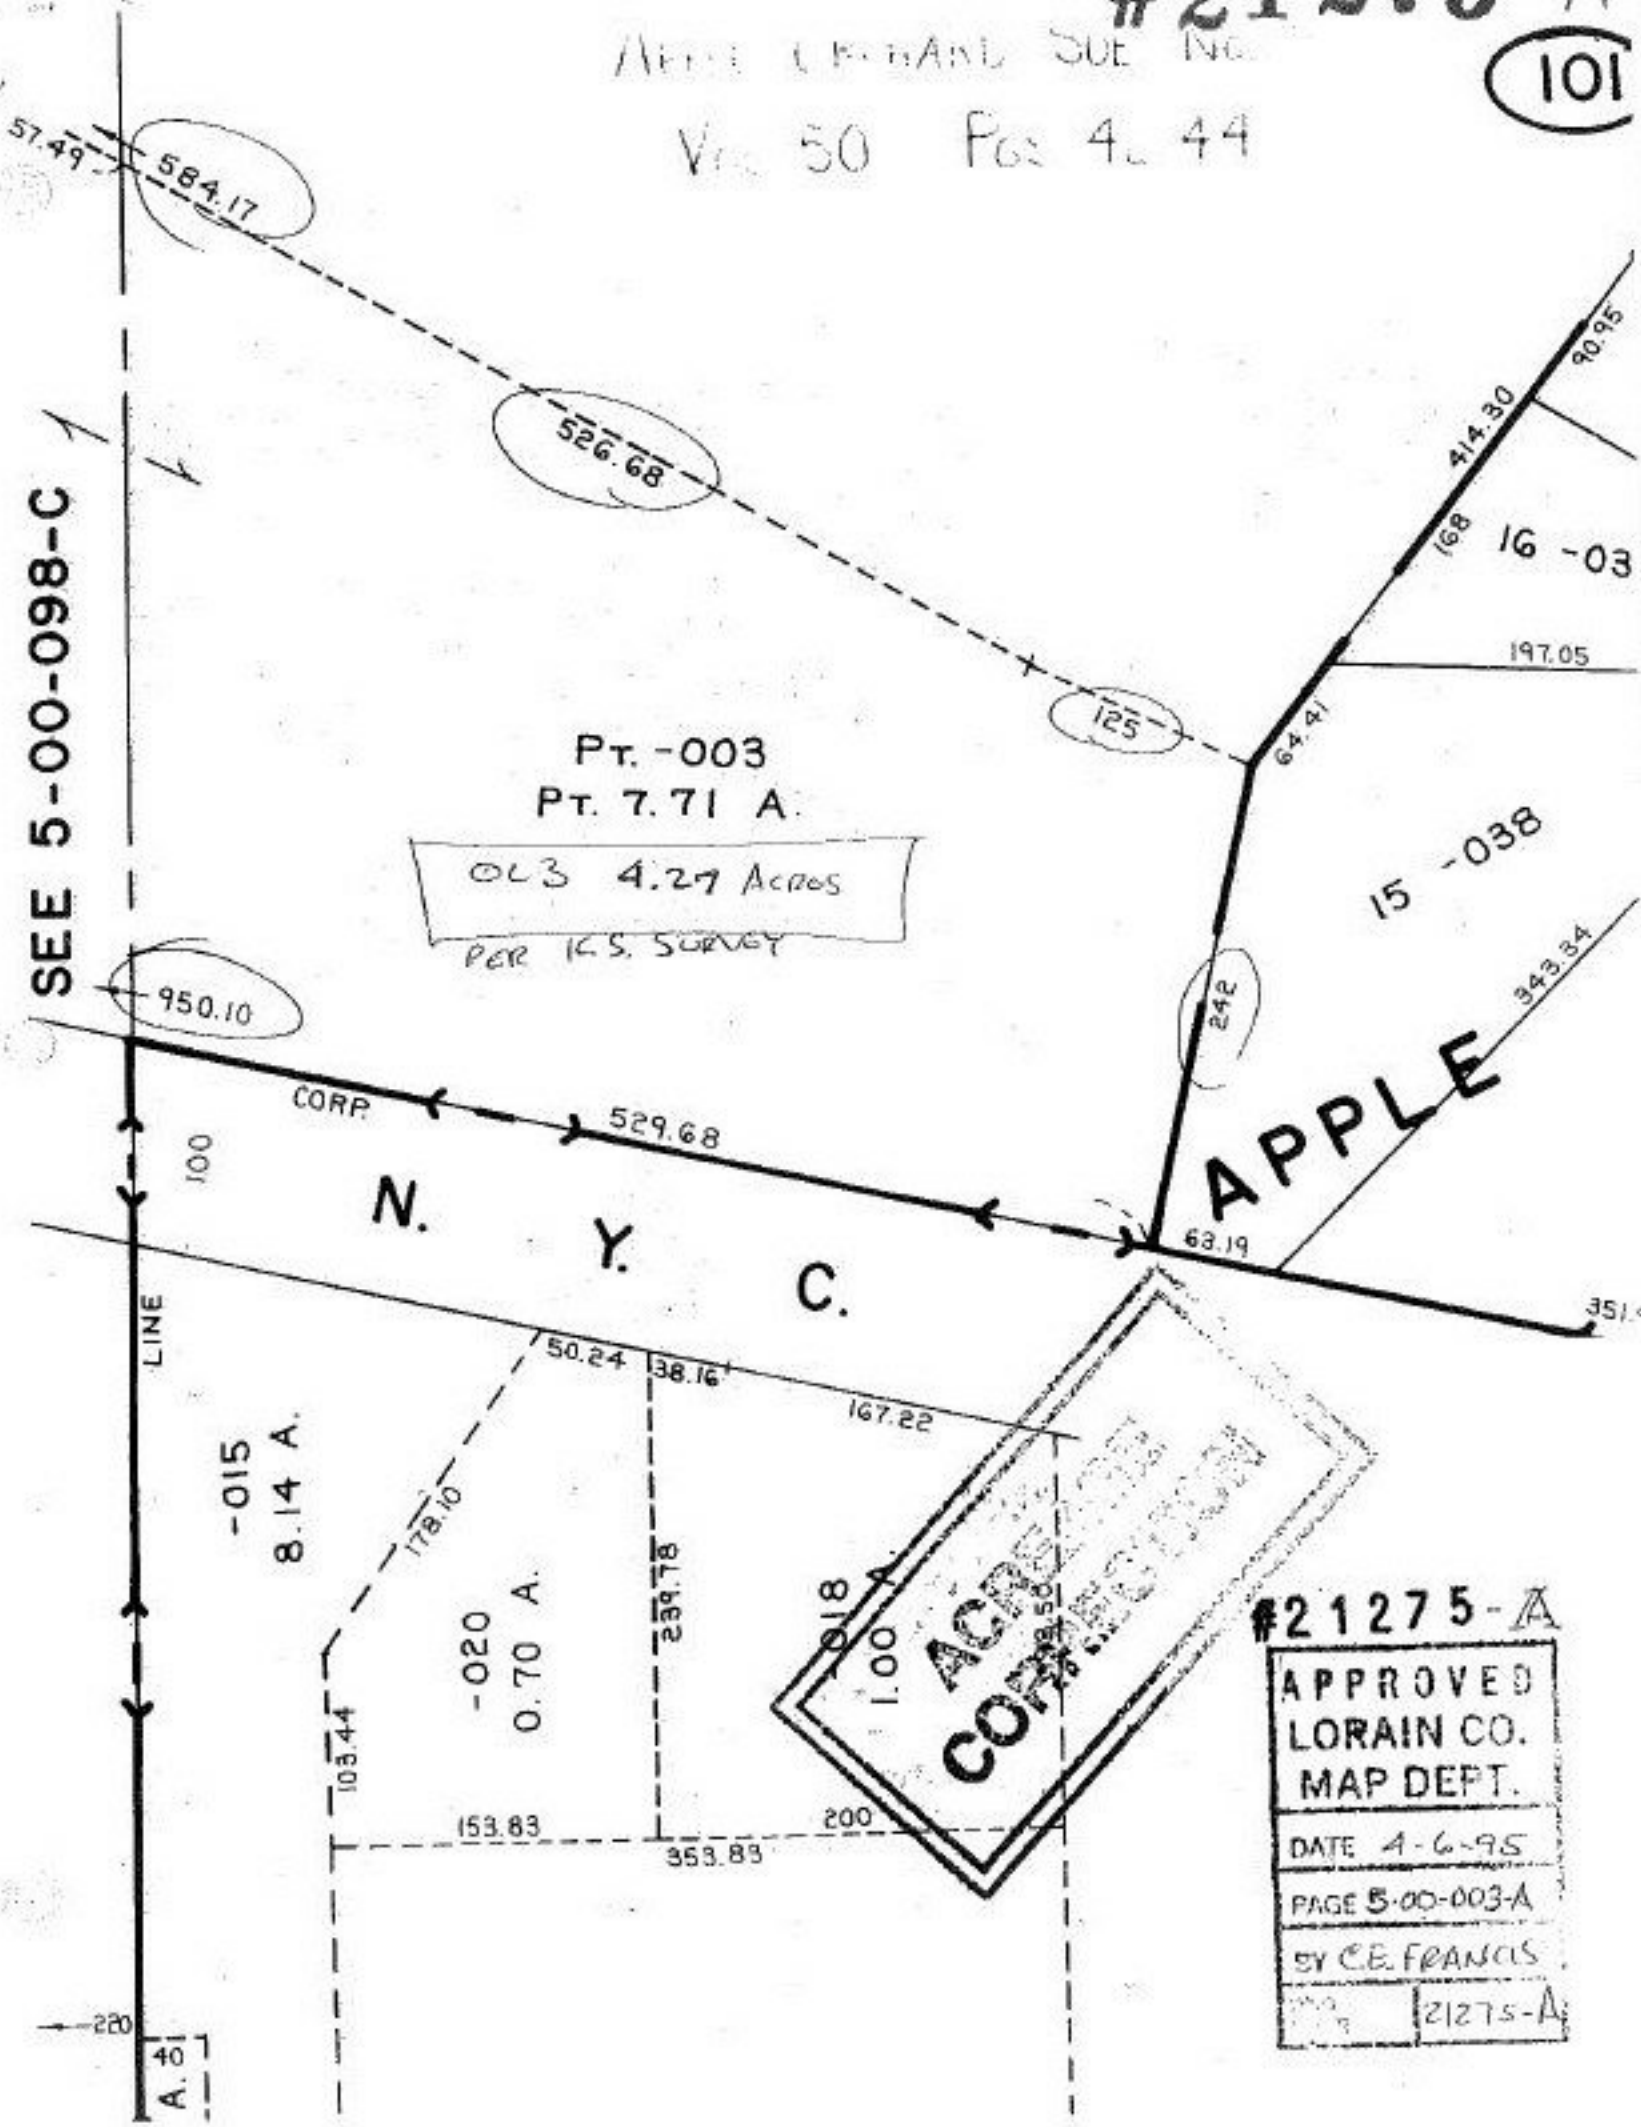

1.00 A.  
ACRES  
CORPORATION

#21275-A

APPROVED  
LORAIN CO.  
MAP DEPT.  
DATE 4-6-95  
PAGE 5-00-003-A  
BY C.E. FRANCIS  
21275-A