


CLARK Rd

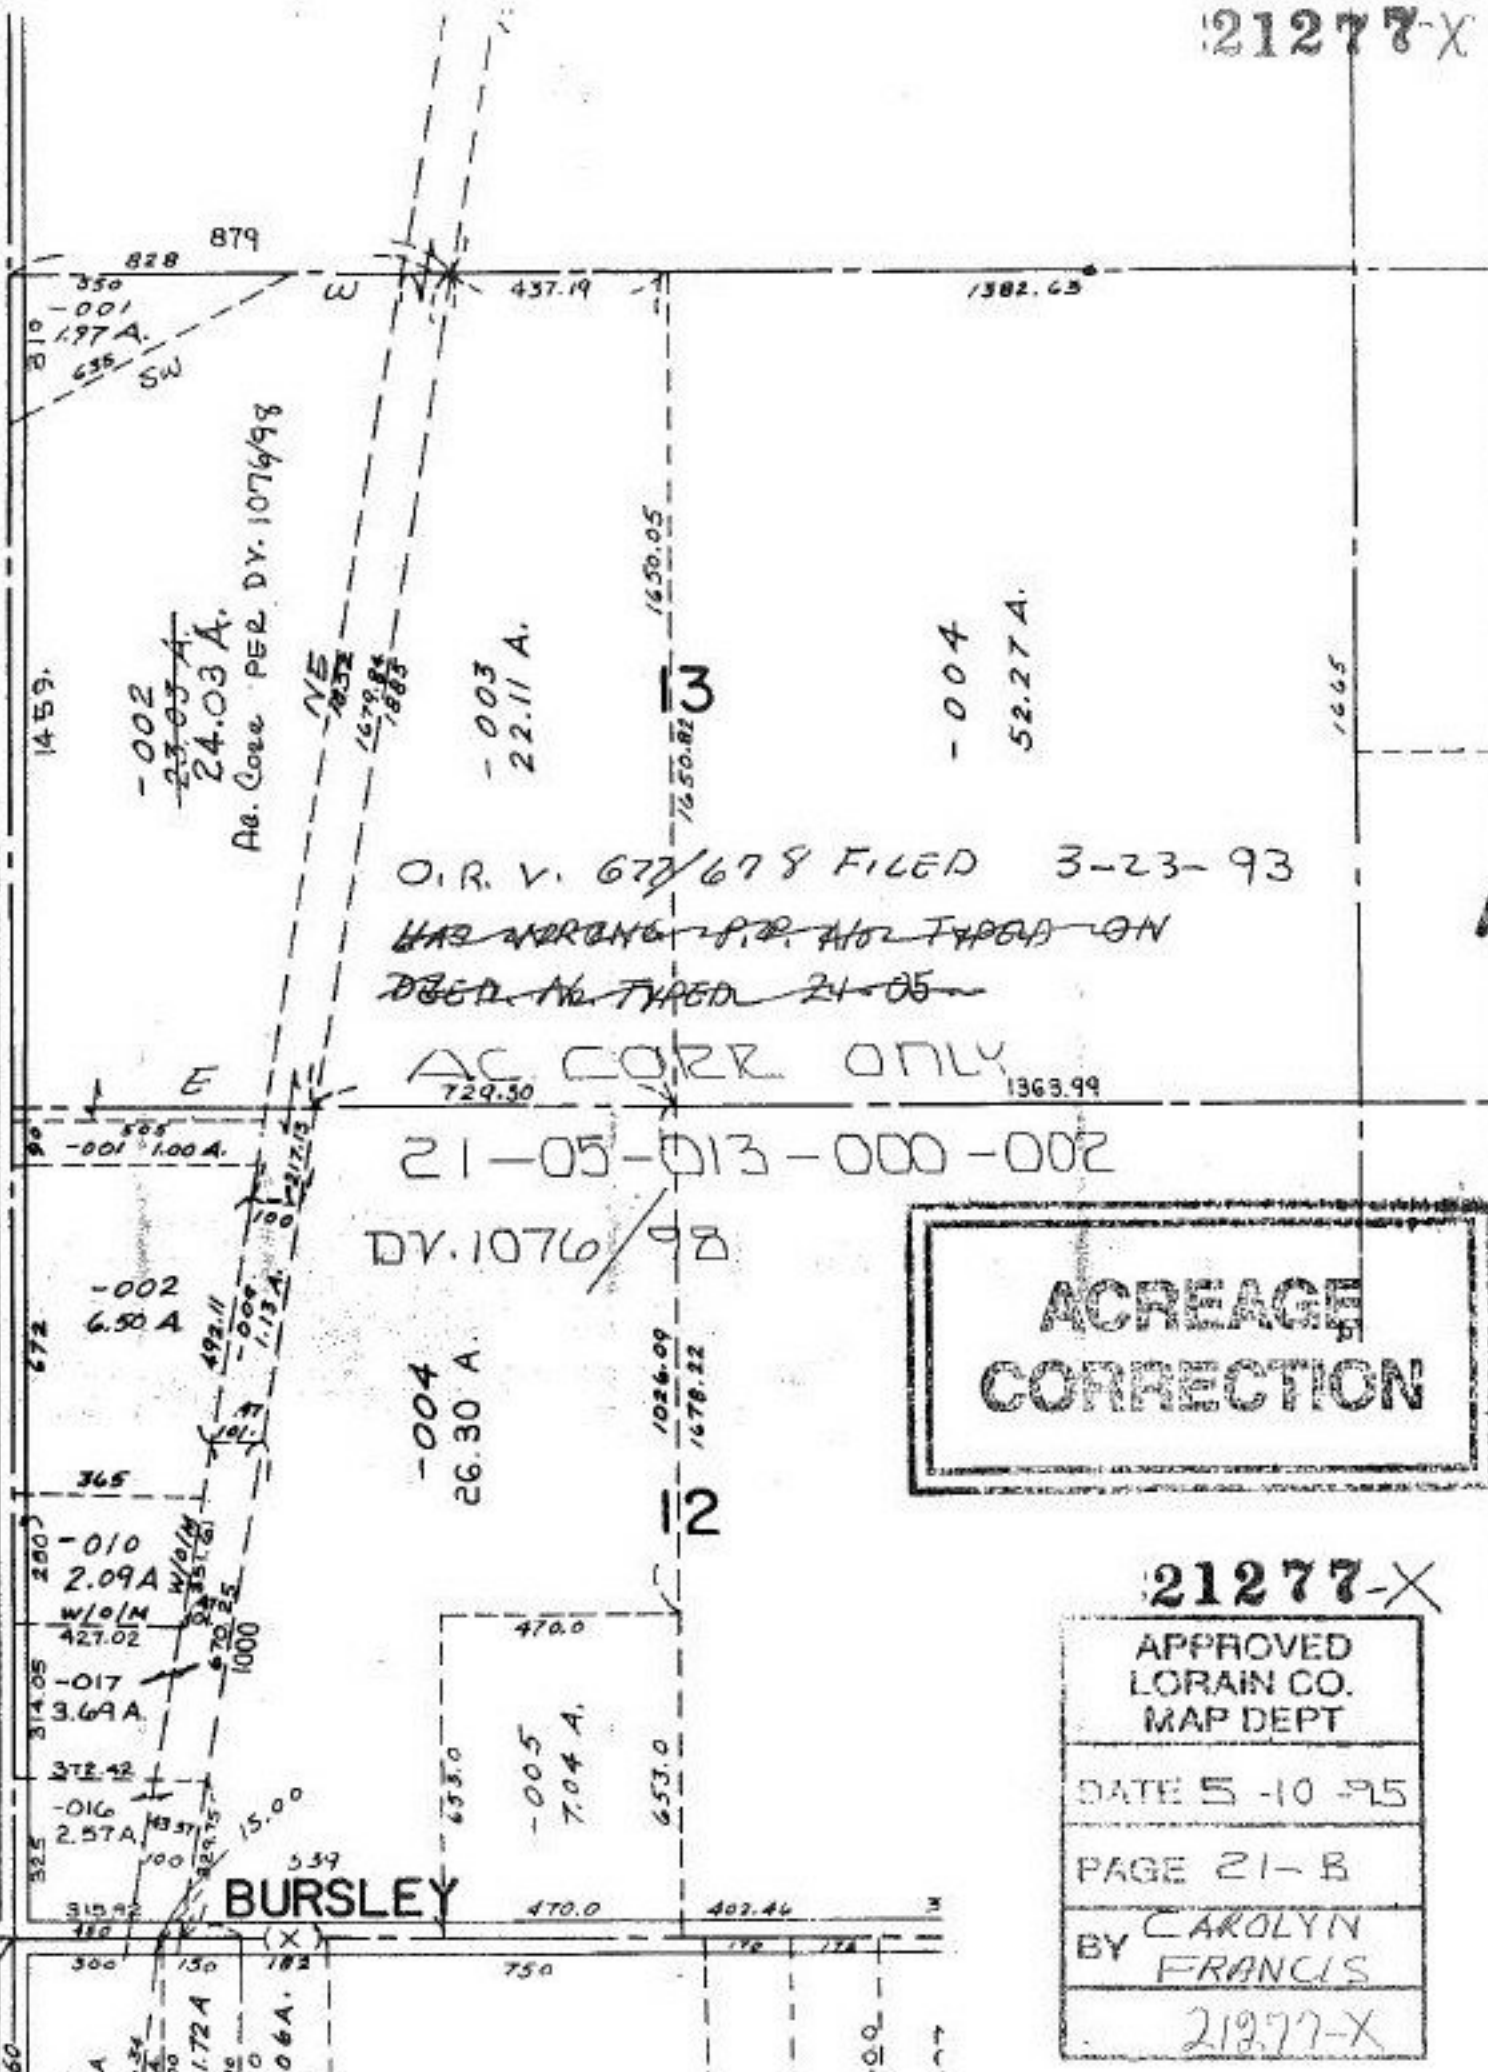

O.R. V. 677/678 FILED 3-23-93
 HAS WORKING P.R. NOT TYPED ON
 DEED. NOT TYPED 24-05

AC CORR ONLY
 729.30 1363.99

21-05-013-000-002

DY. 1076/98

**ACREAGE
CORRECTION**

APPROVED
 LORAIN CO.
 MAP DEPT
 DATE 5-10-95
 PAGE 21-B
 BY CAROLYN
 FRANCIS
 21277-X