

128


2084.47

2

554.57  
 W. LINE SECTION 18  
 THIS IS BEAR LINE OF THIS  
 PARCEL (DETAIL)

~~PT. 172~~ Pt. -181  
~~PT. 24.57 A.~~ Pt. 24.56 A.

1557.06

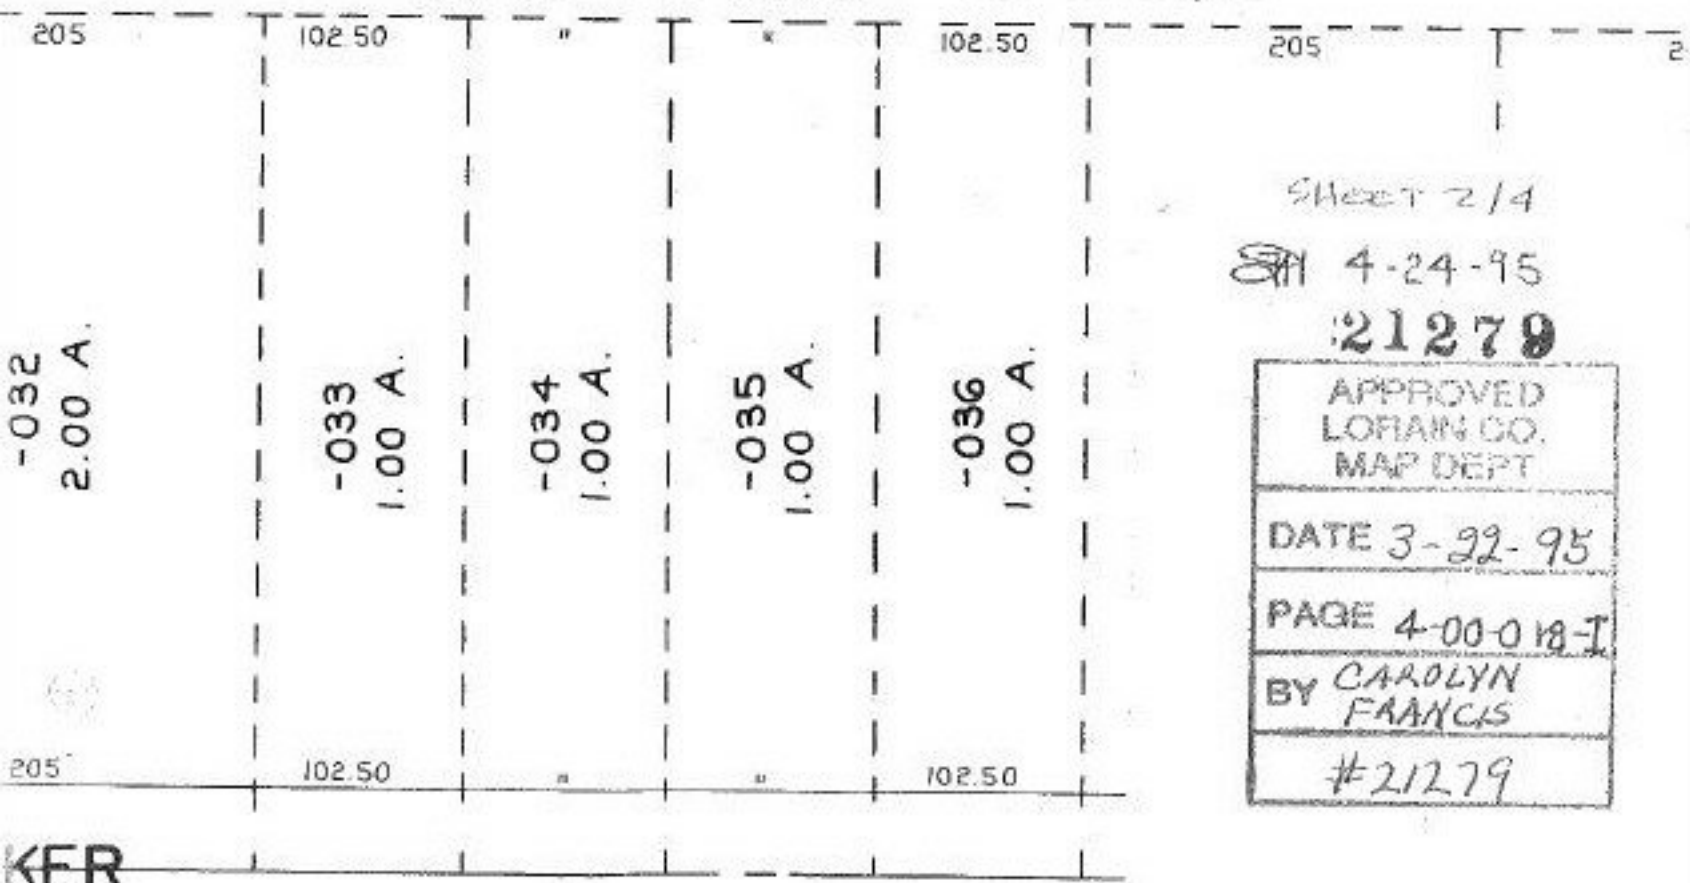

SHEET 2/4

4-24-95

21279

APPROVED  
 LORAIN CO.  
 MAP DEPT

DATE 3-22-95

PAGE 4-00-018-I

BY CAROLYN FRANCIS

#21279

KER