
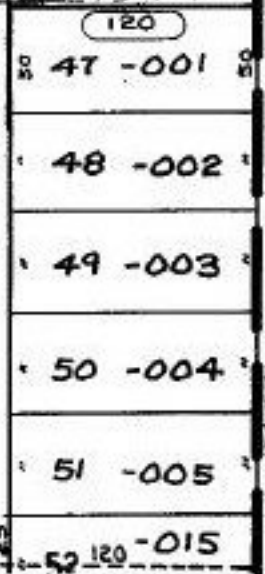
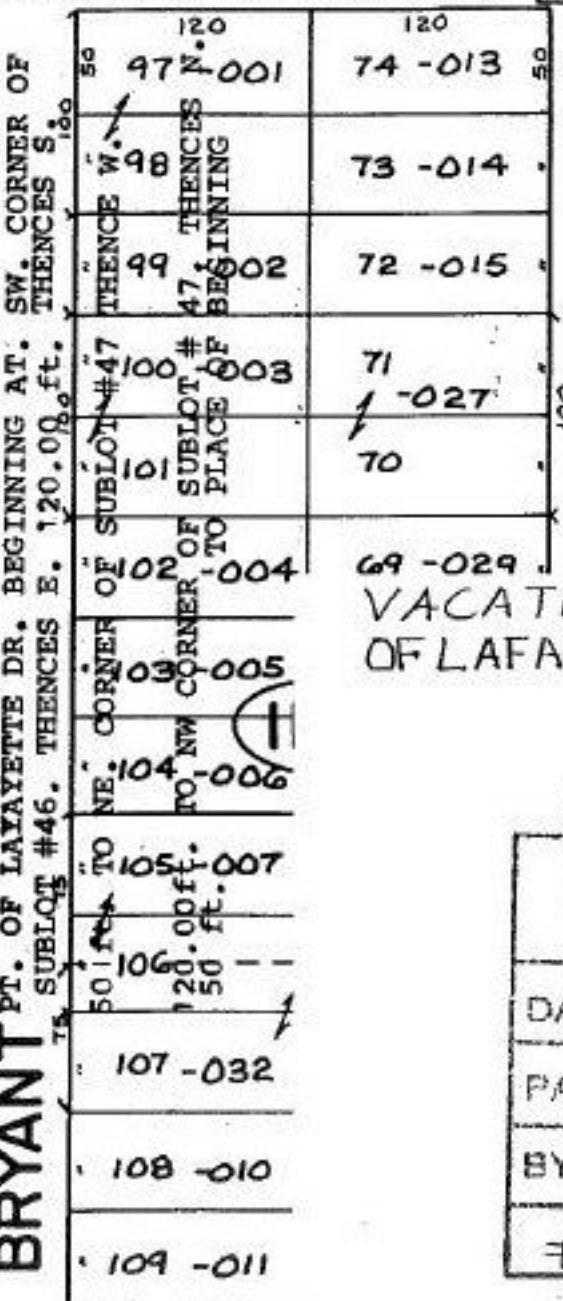


LAFAYETTE DR.

ST. VACATION: VACATING A PT. OF LAFAYETTE DR. PER RES. NO. 95-152 DATED 2-16-1995

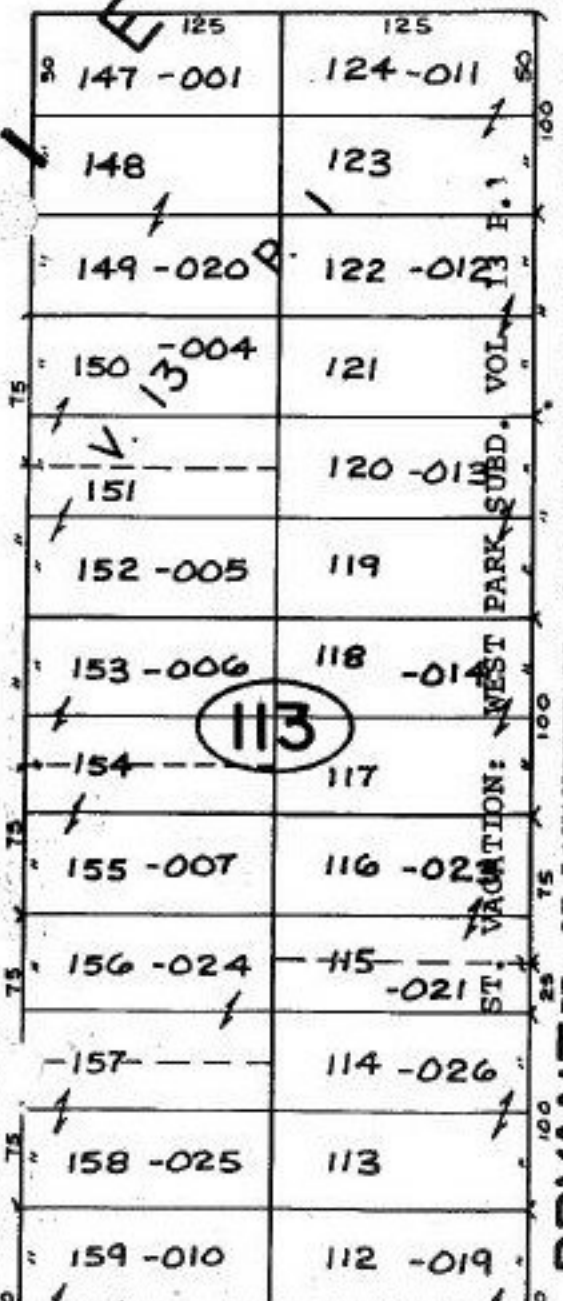

VACATION - SECTION OF LAFAYETTE DR.

21280-V

APPROVED  
LORAIN CO.  
MAP DEPT

DATE 7-11-95

PAGE 12-00-020B

BY CAROLYN  
FRANCIS

# 21280 V

ST. VACATION

SEE 12-D

CULFAX