


#21286D

EXHIBIT-A
12-00-035-101-013 IS NOT PART
OF LEGAL DESCRIPTION.
P.P. NO. TYPING ERROR
12-00-047-003-002 SHOULD BE
CORR TO: 12-00-047-103-002

PROBLEM:

SQUIRE NEED TO SHOW NW TAKEN
BY EASEMENT. Ac. being conveyed

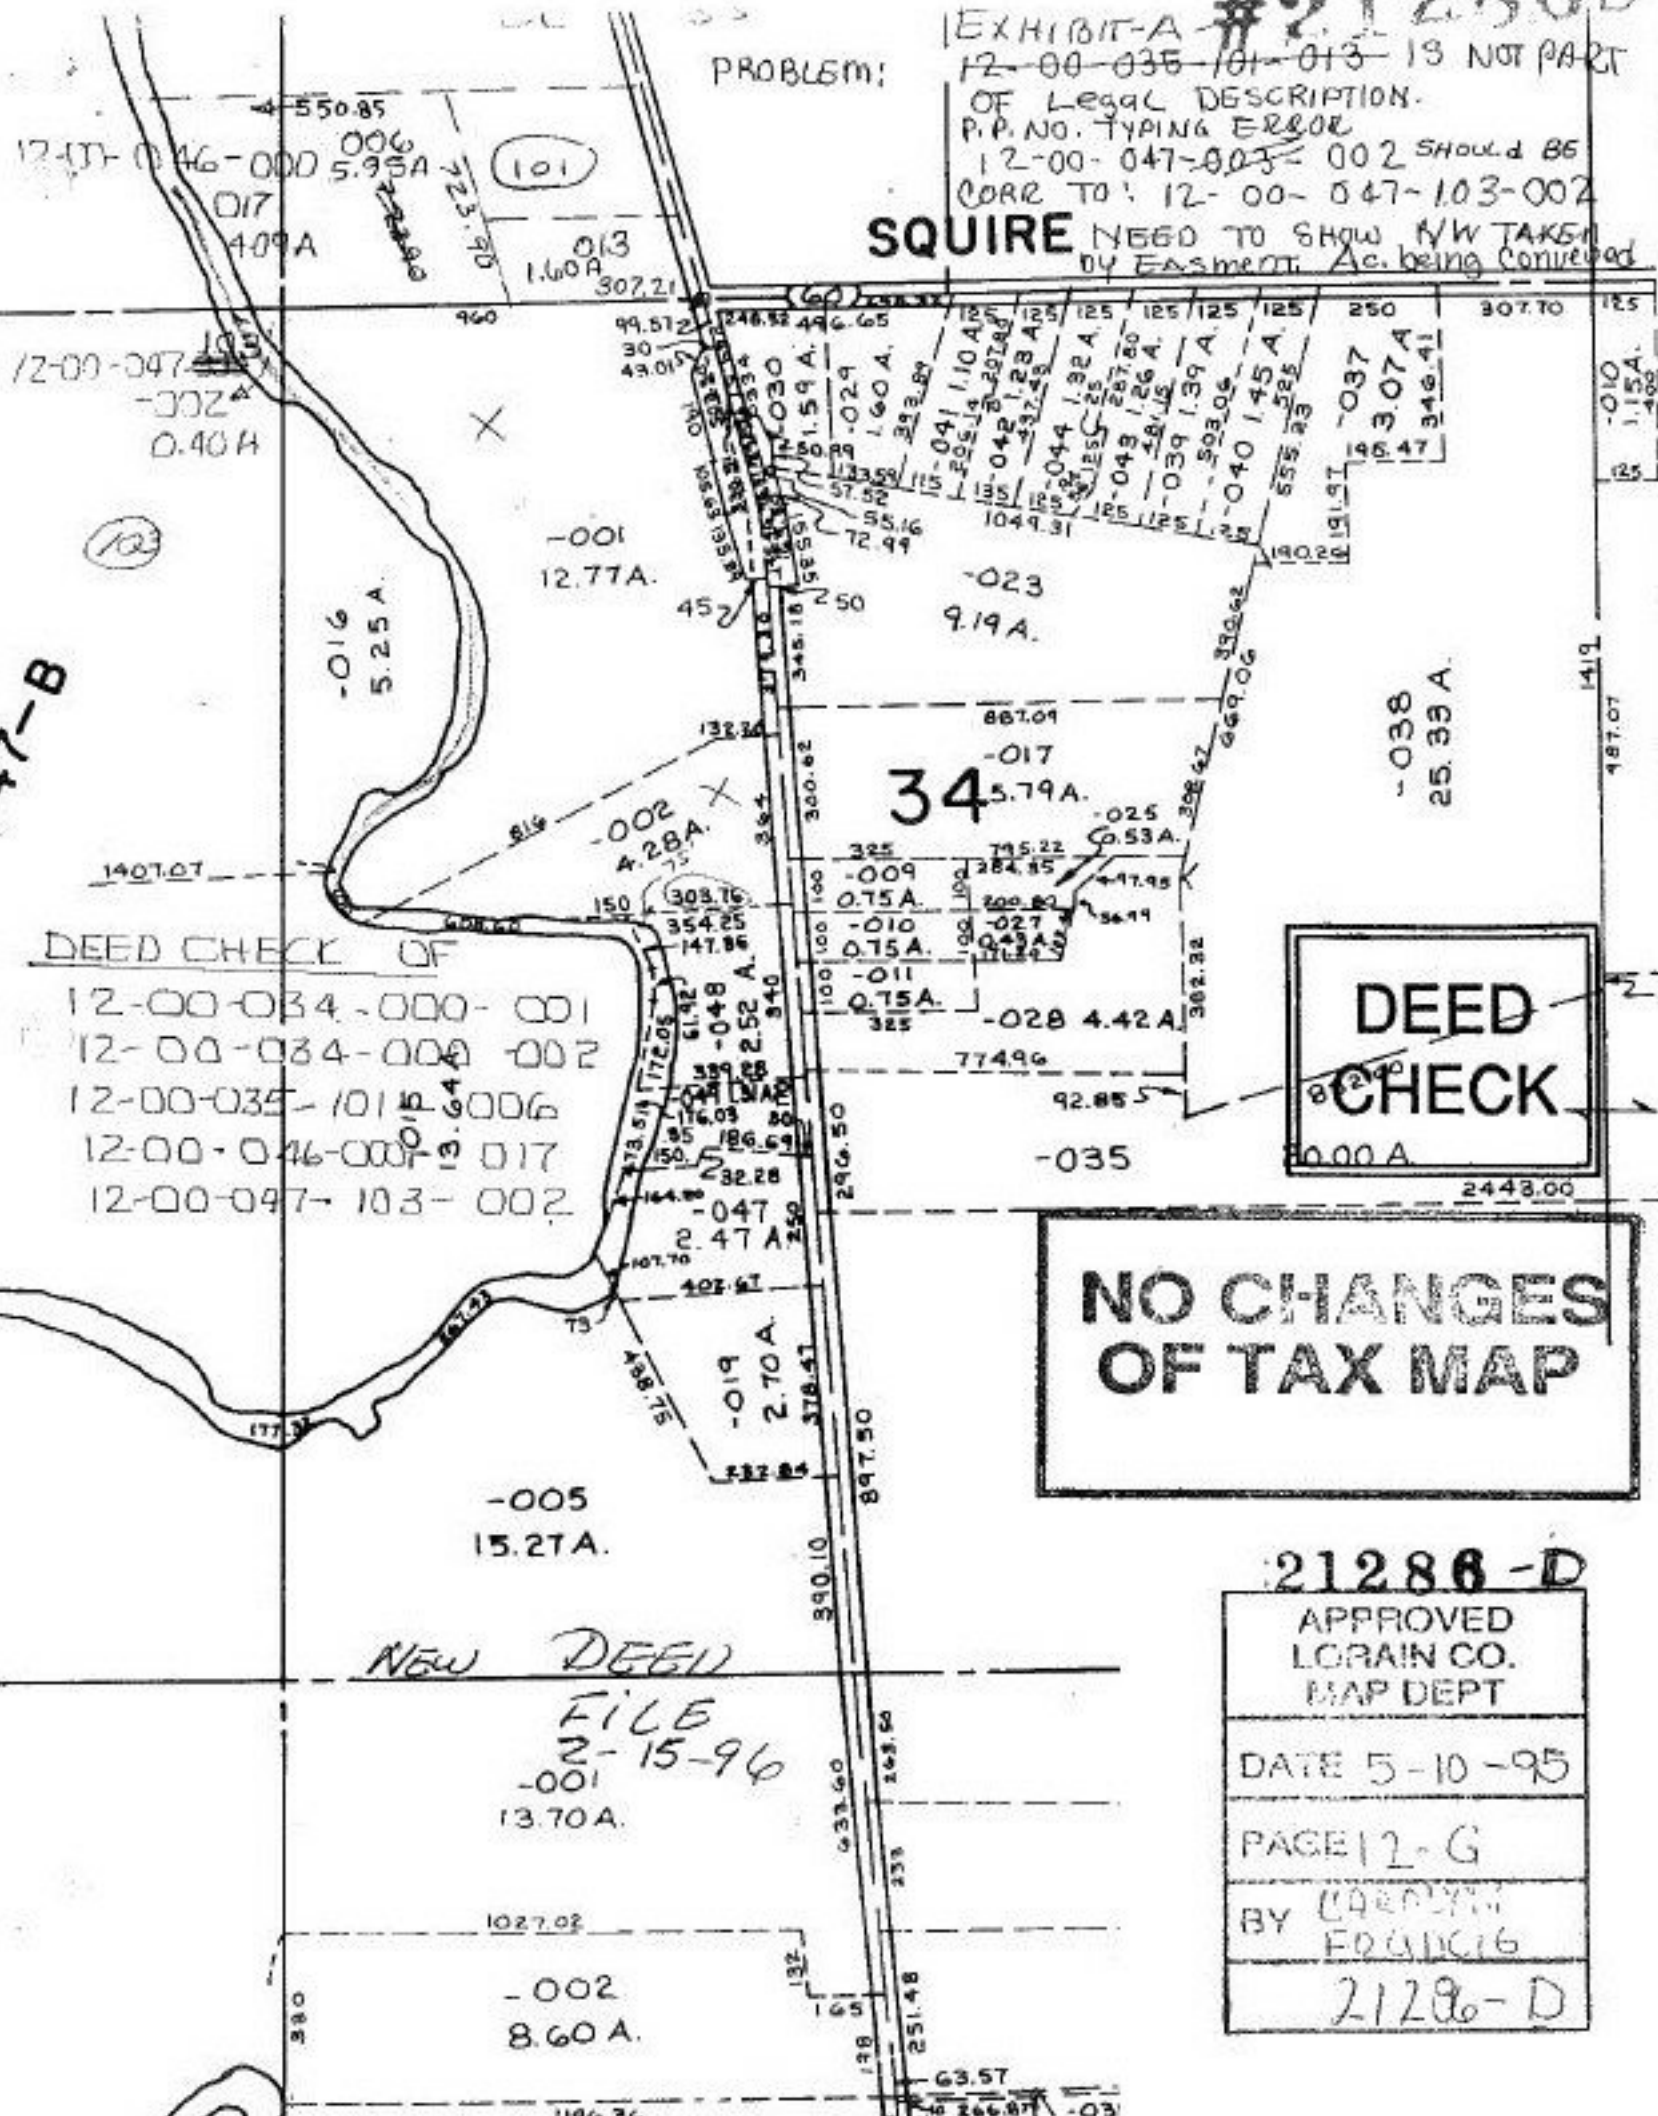

12-00-046-000-006
017
409A
550.85
5.95A
23.37
101

12-00-047-103-002A
0.40A

47-B

DEED CHECK OF
12-00-034-000-001
12-00-034-000-002
12-00-035-101-0006
12-00-046-000-017
12-00-047-103-002

DEED
CHECK

NO CHANGES
OF TAX MAP

NEW DEED
FILE
2-15-96
-001
13.70A.

21286-D
APPROVED
LORAIN CO.
MAP DEPT
DATE 5-10-95
PAGE 12-G
BY CAROLYN
FRANCIS
21286-D

1027.02
-002
8.60A.
1196.36
63.57
266.87
-03