


G 28.08

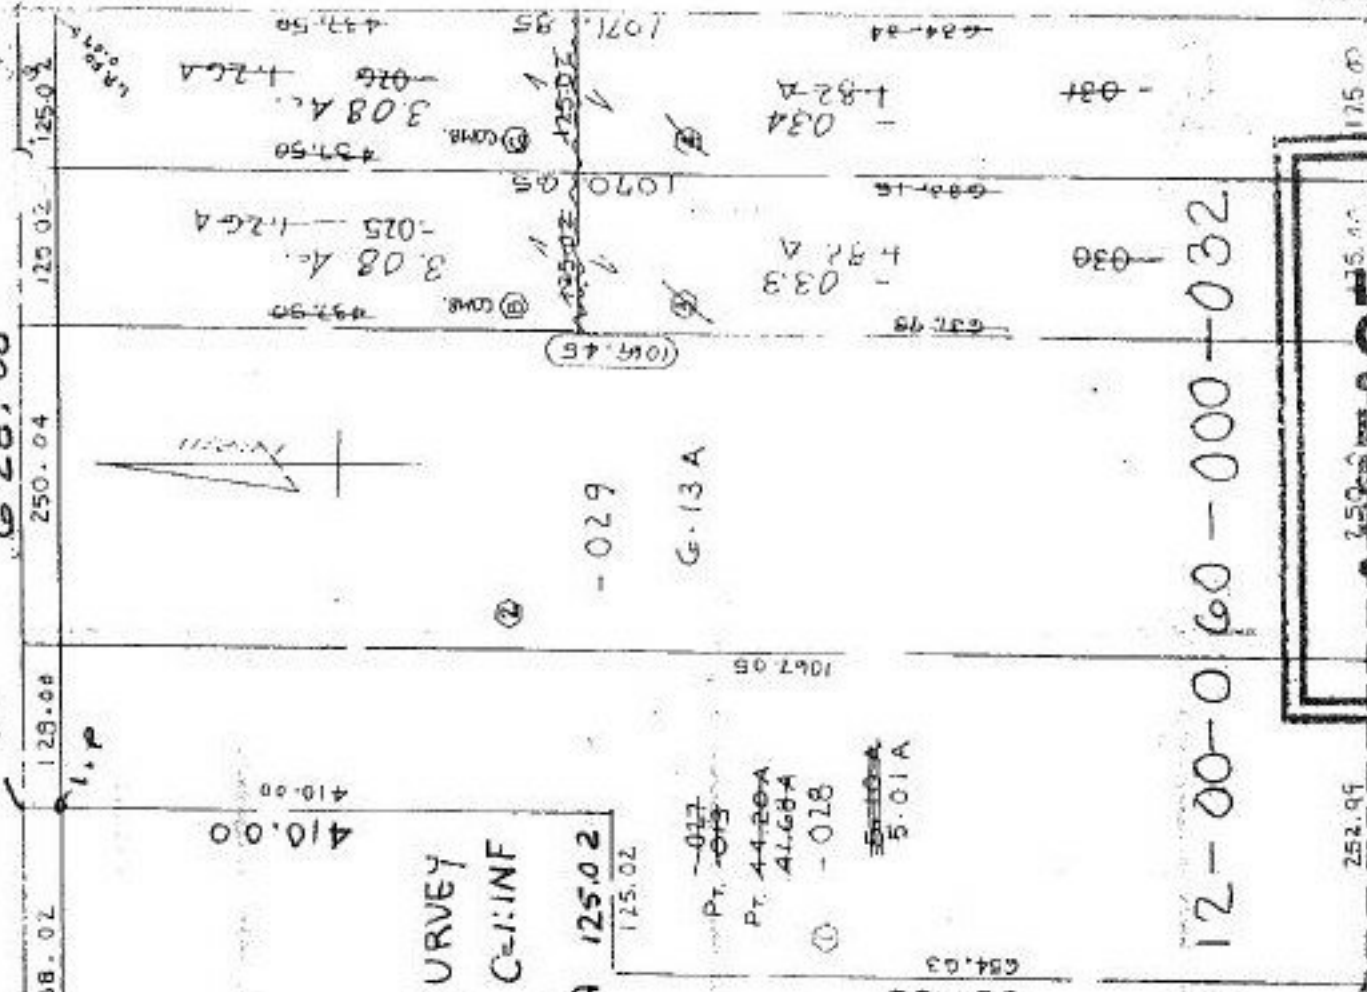

PRIOR INST.  
DY. 1017/520

AC. CORR. PER SURVEY

PL. - 032 C=1:INF

REMAINDER  
GEORGE HOFMANN  
REG. SURVEYOR  
29.29 A 125.02

# 21250

P.F. NO. 12-00-060-000-  
PRIOR INSTR. DY. 1017/520  
CLOSURE: 5.01ac. 0.01ft. error per 10,000 ft.  
6.13ac. 0.01ft. error per 10,000 ft.  
1.82ac. 0.01ft. error per 10,000 ft.  
1.82ac. 0.01ft. error per 10,000 ft.  
3.08ac. 0.01ft. error per 10,000 ft.  
3.08ac. 0.01ft. error per 10,000 ft.

SURVEYED BY: GEORGE A. BOYMAN REG. SURVEYOR

21250

APPROVED
LORAIN CO.
MAP DEPT
DATE 3-6-95
PAGE 12-00-060-000-000
BY CAROLYN FRANCIS
# 21250

21295 A

APPROVED
LORAIN CO.
MAP DEPT
DATE 4-28-95
PAGE 12-00-060-000-000
BY CAROLYN FRANCIS
# 21295

12-00-060-000-032

21295  
**ACREAGE  
CORRECTION**

(1311.58)