


SEE 6-142

ABBE RD

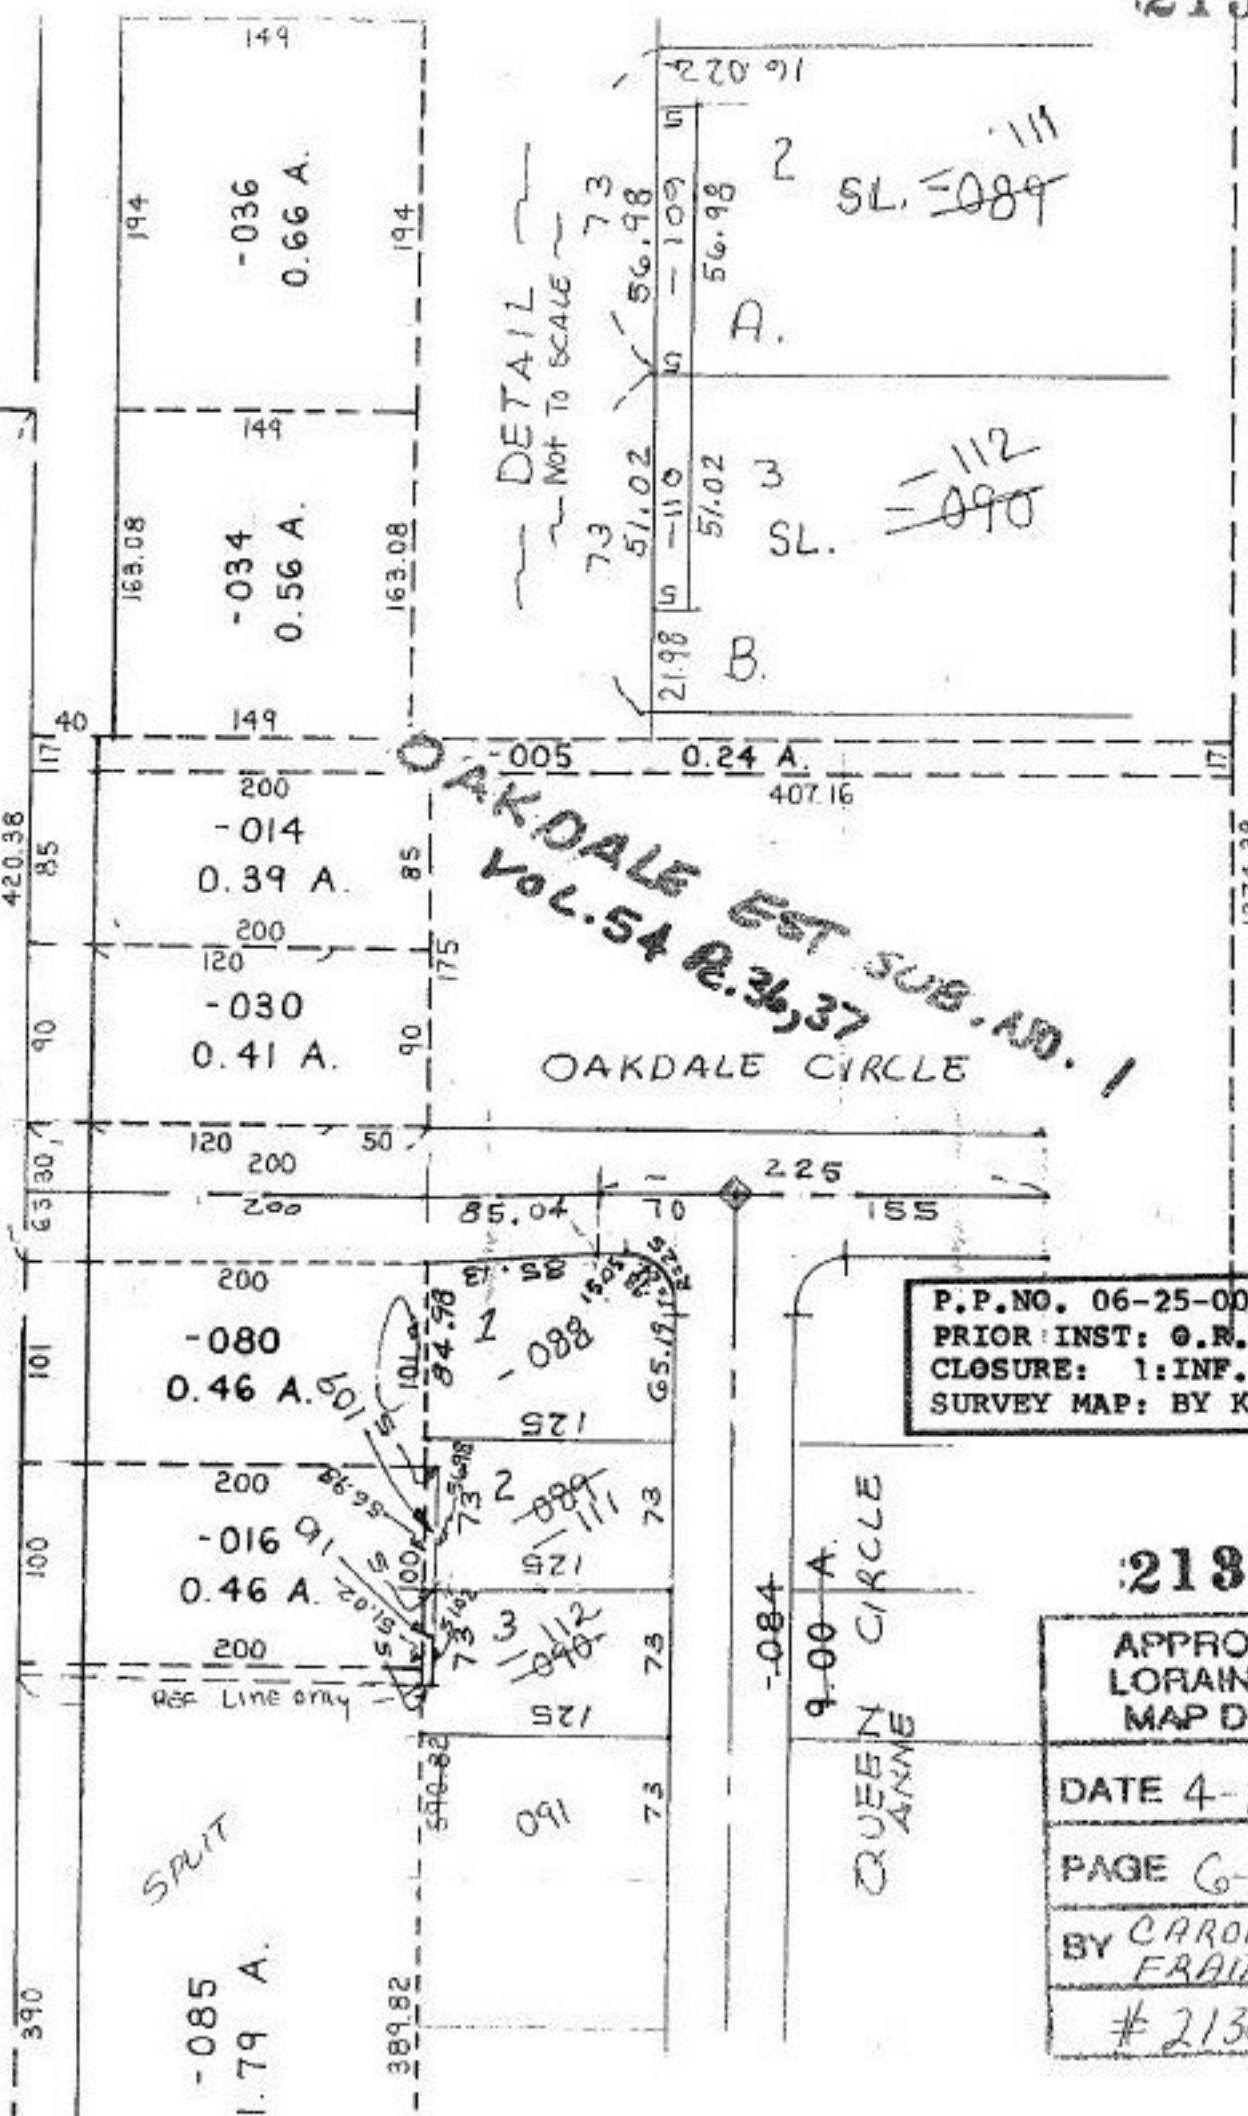

P.P. NO. 06-25-001-000
 PRIOR INST: O.R. 946/410
 CLOSURE: 1:INF.
 SURVEY MAP: BY KSA

21307

APPROVED
 LORAIN CO.
 MAP DEPT

DATE 4-26-95

PAGE 6-143

BY CAROLYN
 FRANKS

21307