


-017
50'A
19

100

-042
5.19A

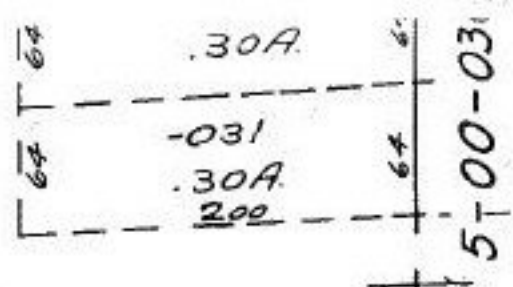


UNCOMBINATION OF:

419.44
05-00-011-105-046
0.54A

INTD:- 05-00-011-105-062 0.27
-063 0.27
0.54A

DEED FILED 4-28-95
O.R.V. 1074/623

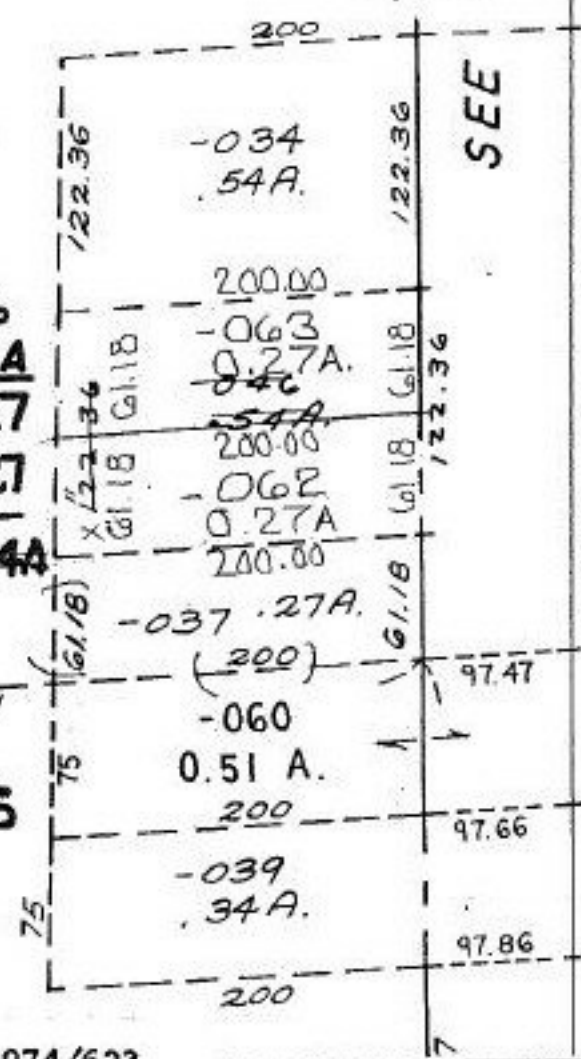

UNCOMB.

UNCOMBINATION PER DEED O.R.V. 1074/623
PARCELS IS SHOWN AS TWO PARCELS ON DEED.

-061
9.53 A.

UNCOMBINATION OF:
P.P.NO. 05-00-011-105-046
INST: O.R. 1074/623

APPROVED LORAIN CO. MAP DEPT
DATE 6-30-95
PAGE 5-00-011-B
BY CAROLYN FRANCIS
21321-U

929.93

28.40

500