


21349

BEGINNING IN THE CENTERLINE OF OVERBROOK DR. AND INTERSECTING CENTERLINE OF MEDINA ELYRIA RD. THENCE 155.66 ft. TO ANGLE CONTINUE IN OVERBROOK DR. CENTERLINE 1000.00 ft. to point of CURVE. THENCE NW 30 ft. to P.P. of BEGINNING THENCE 65.36'

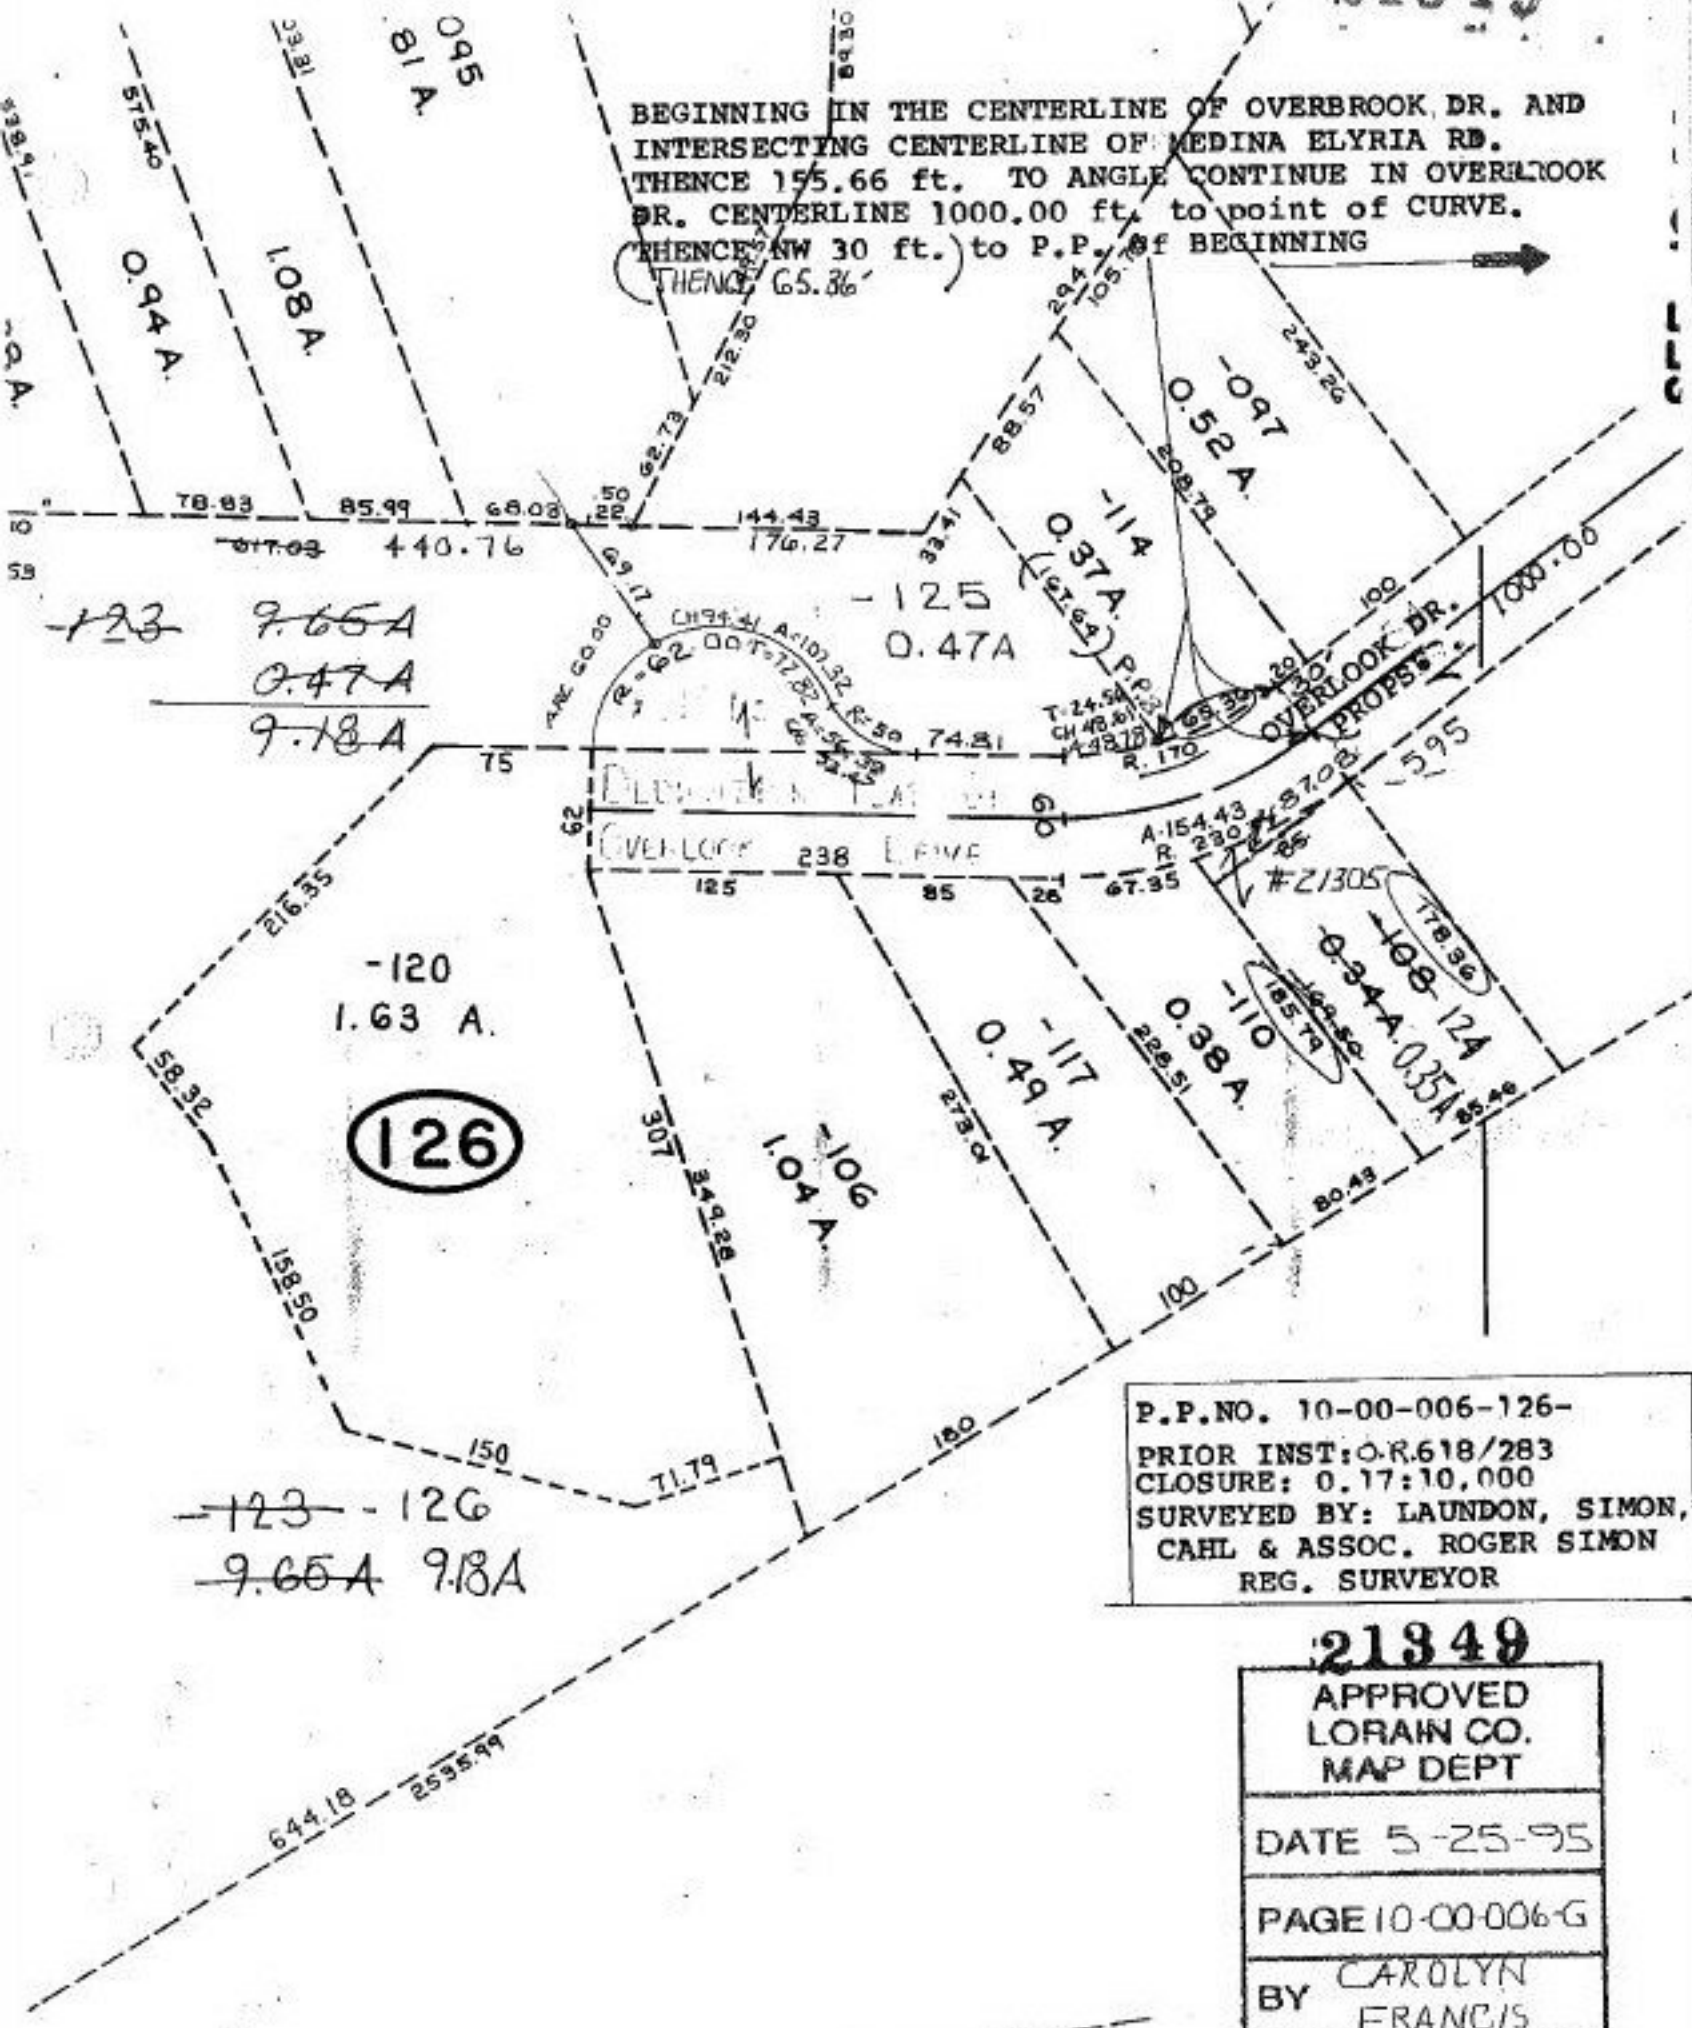

123 9.65A
0.47A
9.18A

126
1.63 A.

123 - 126
9.65A 9.18A

P.P. NO. 10-00-006-126-
PRIOR INST: O.R. 618/283
CLOSURE: 0.17:10,000
SURVEYED BY: LAUNDON, SIMON,
CAHL & ASSOC. ROGER SIMON
REG. SURVEYOR

21349

APPROVED
LORAIN CO.
MAP DEPT
DATE 5-25-95
PAGE 10-00-006-G
BY CAROLYN
FRANCIS
21349