


224.81
2135

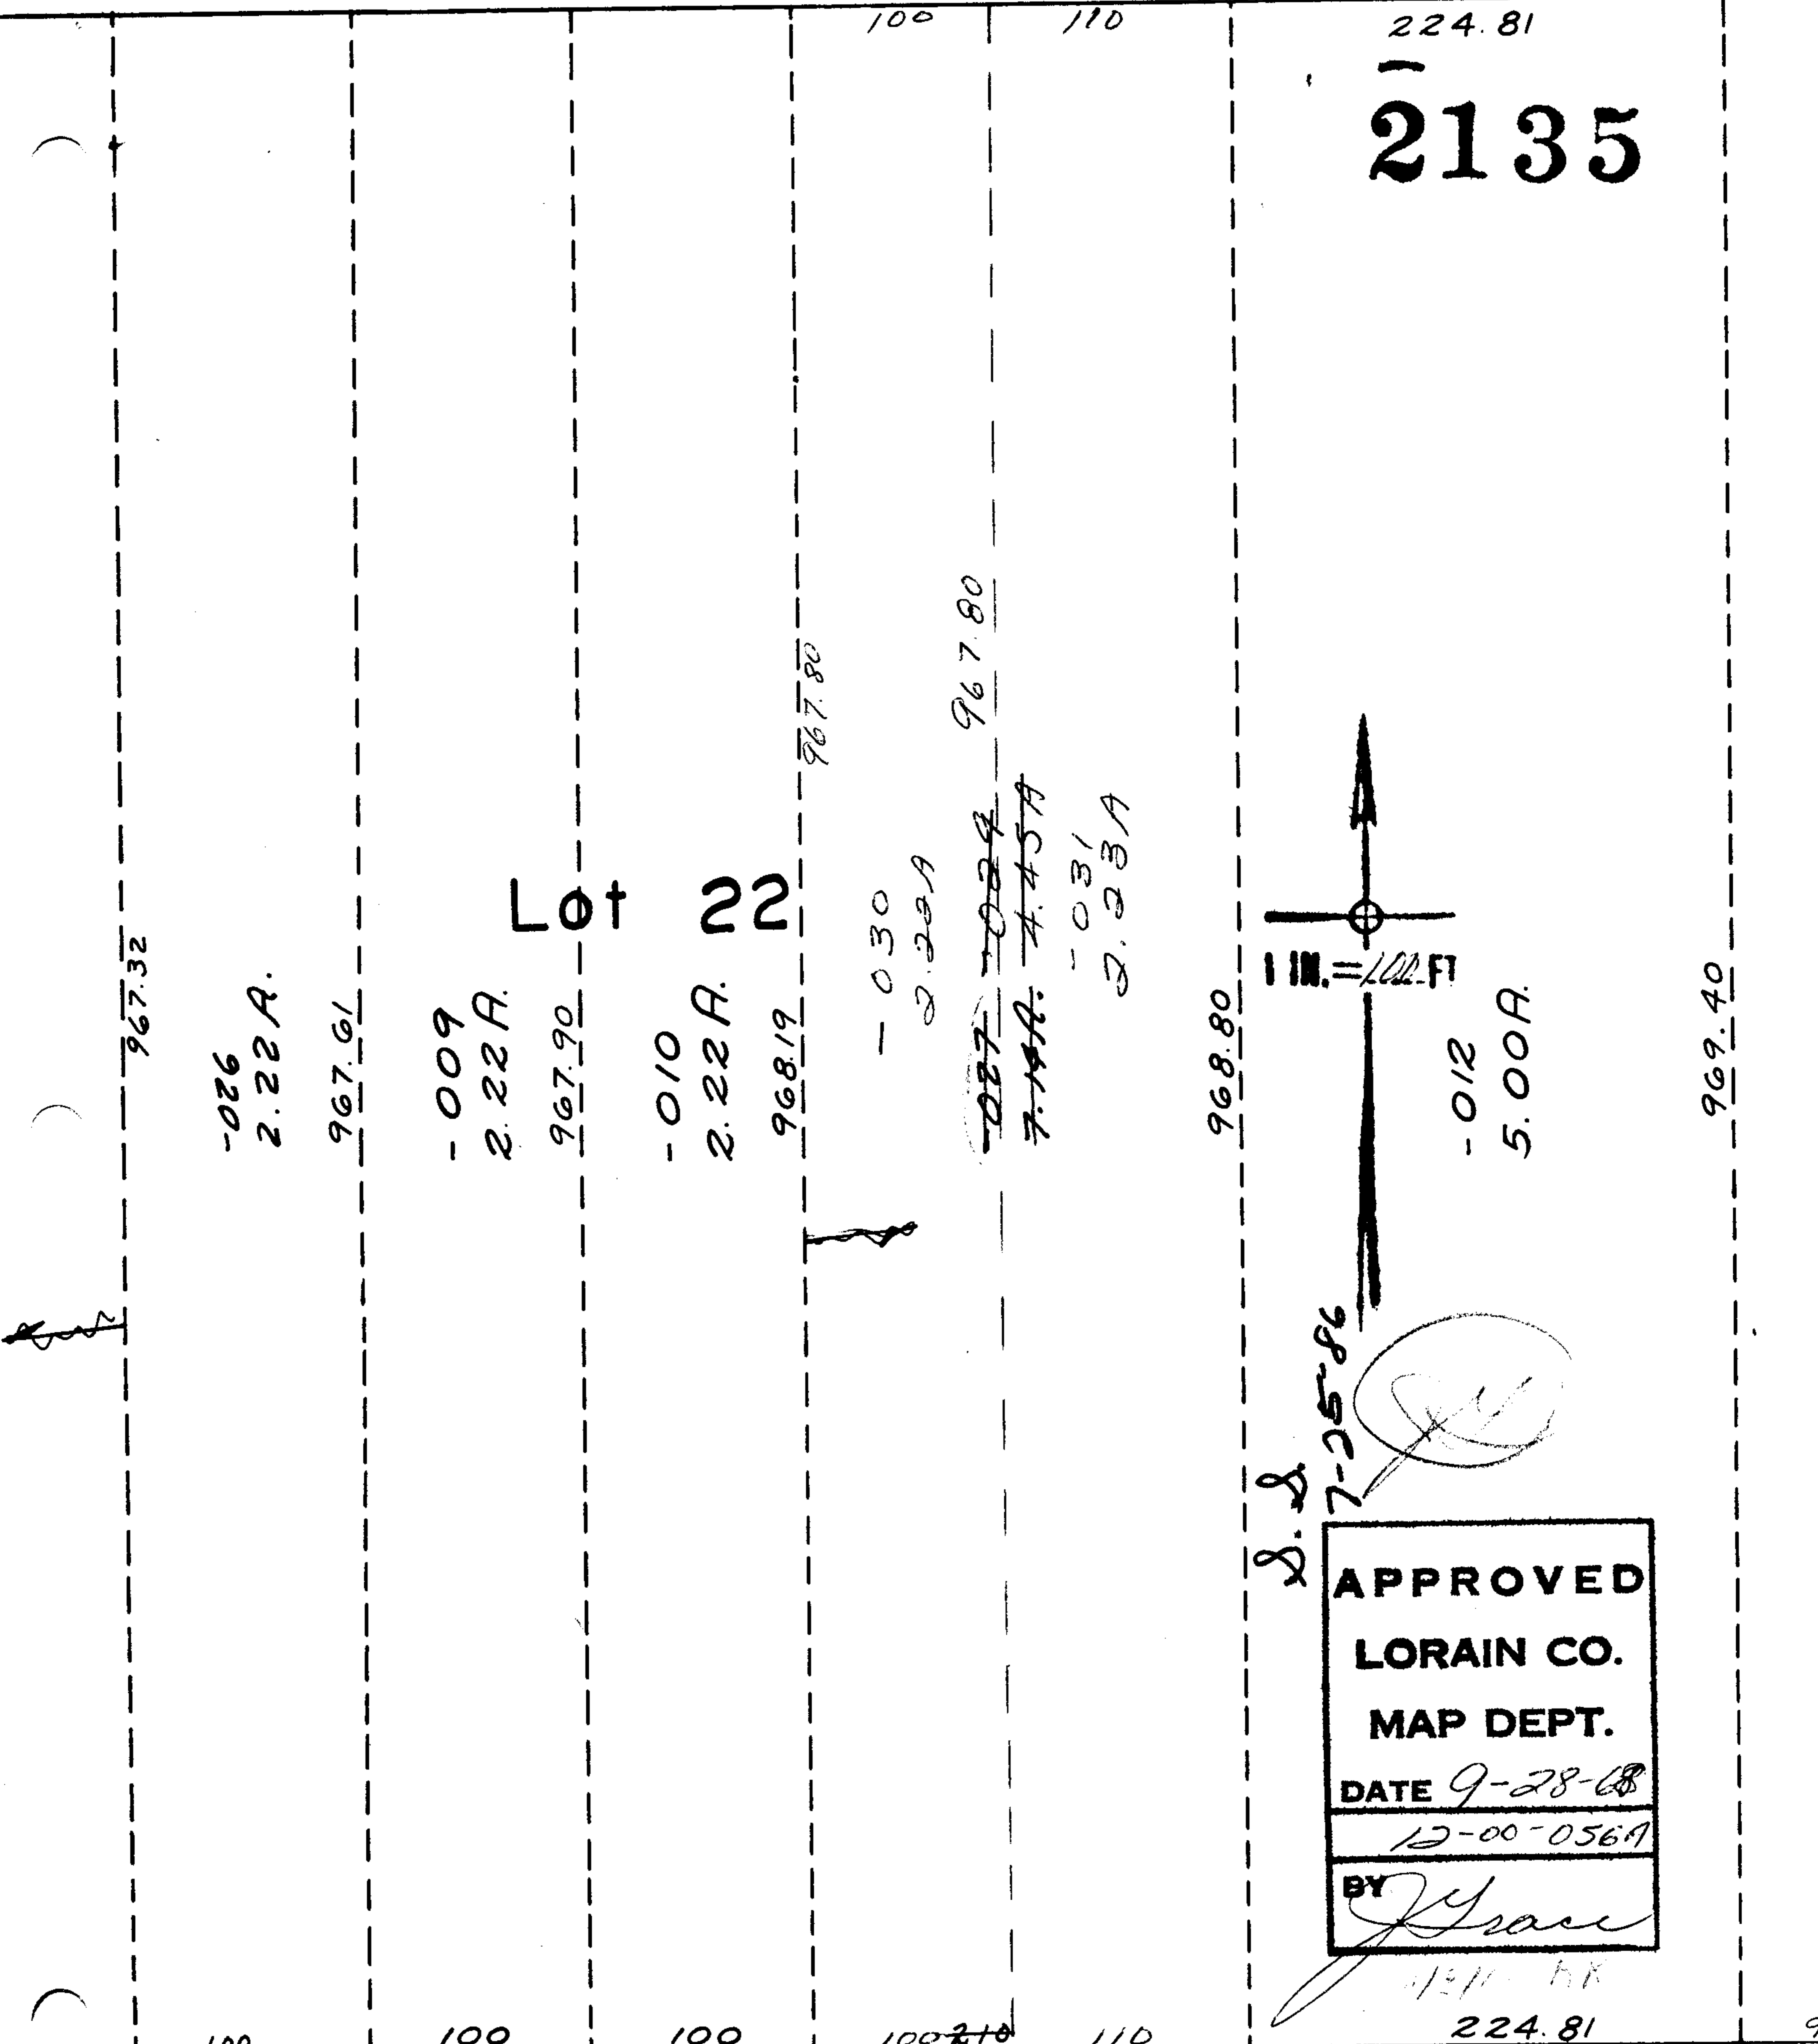

TWINSBURG

SEE 12-00-055-A

82

RD.

APPROVED
LORAIN CO.
MAP DEPT.
 DATE 9-28-68
 12-00-056A
 BY *J. Grace*

D. J. 7-25-86

