


BLE

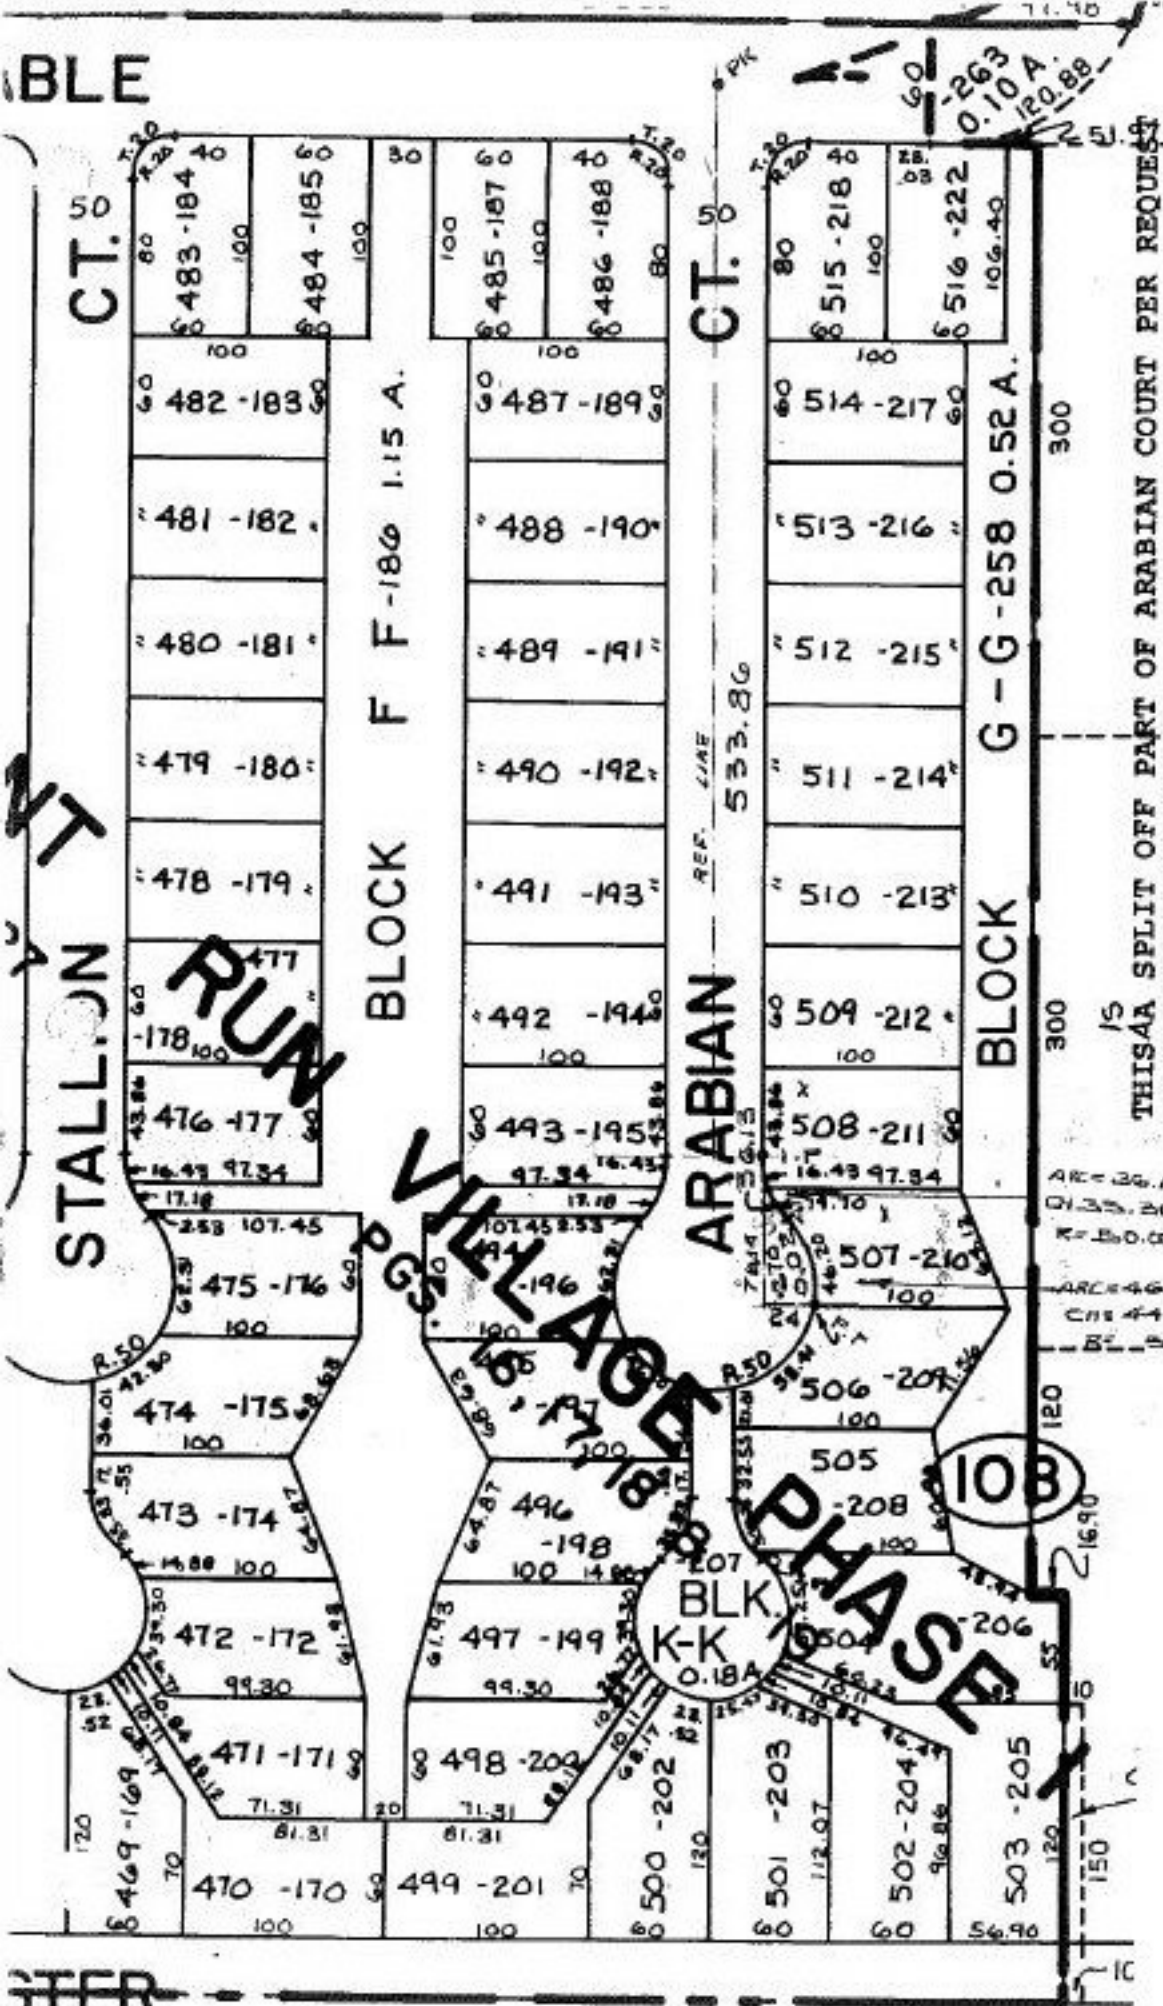

THIS IS A SPLIT OFF PART OF ARABIAN COURT PER REQUEST OF PHEASANT RUN ASSOC.

PARCEL NUMBER IS BEING ADDED TO BUP.

15-00-098-108-270

644.72
592.7

-26
4.07

589.91

-261
4.05

21350

APPROVED
LORAIN CO.
MAP DEPT

DATE 5-25-95

PAGE 15-00-098-B

BY CAROLYN
FRANCIS

21350

SEE 19-A