


ST.

MAIN ST.

115.55

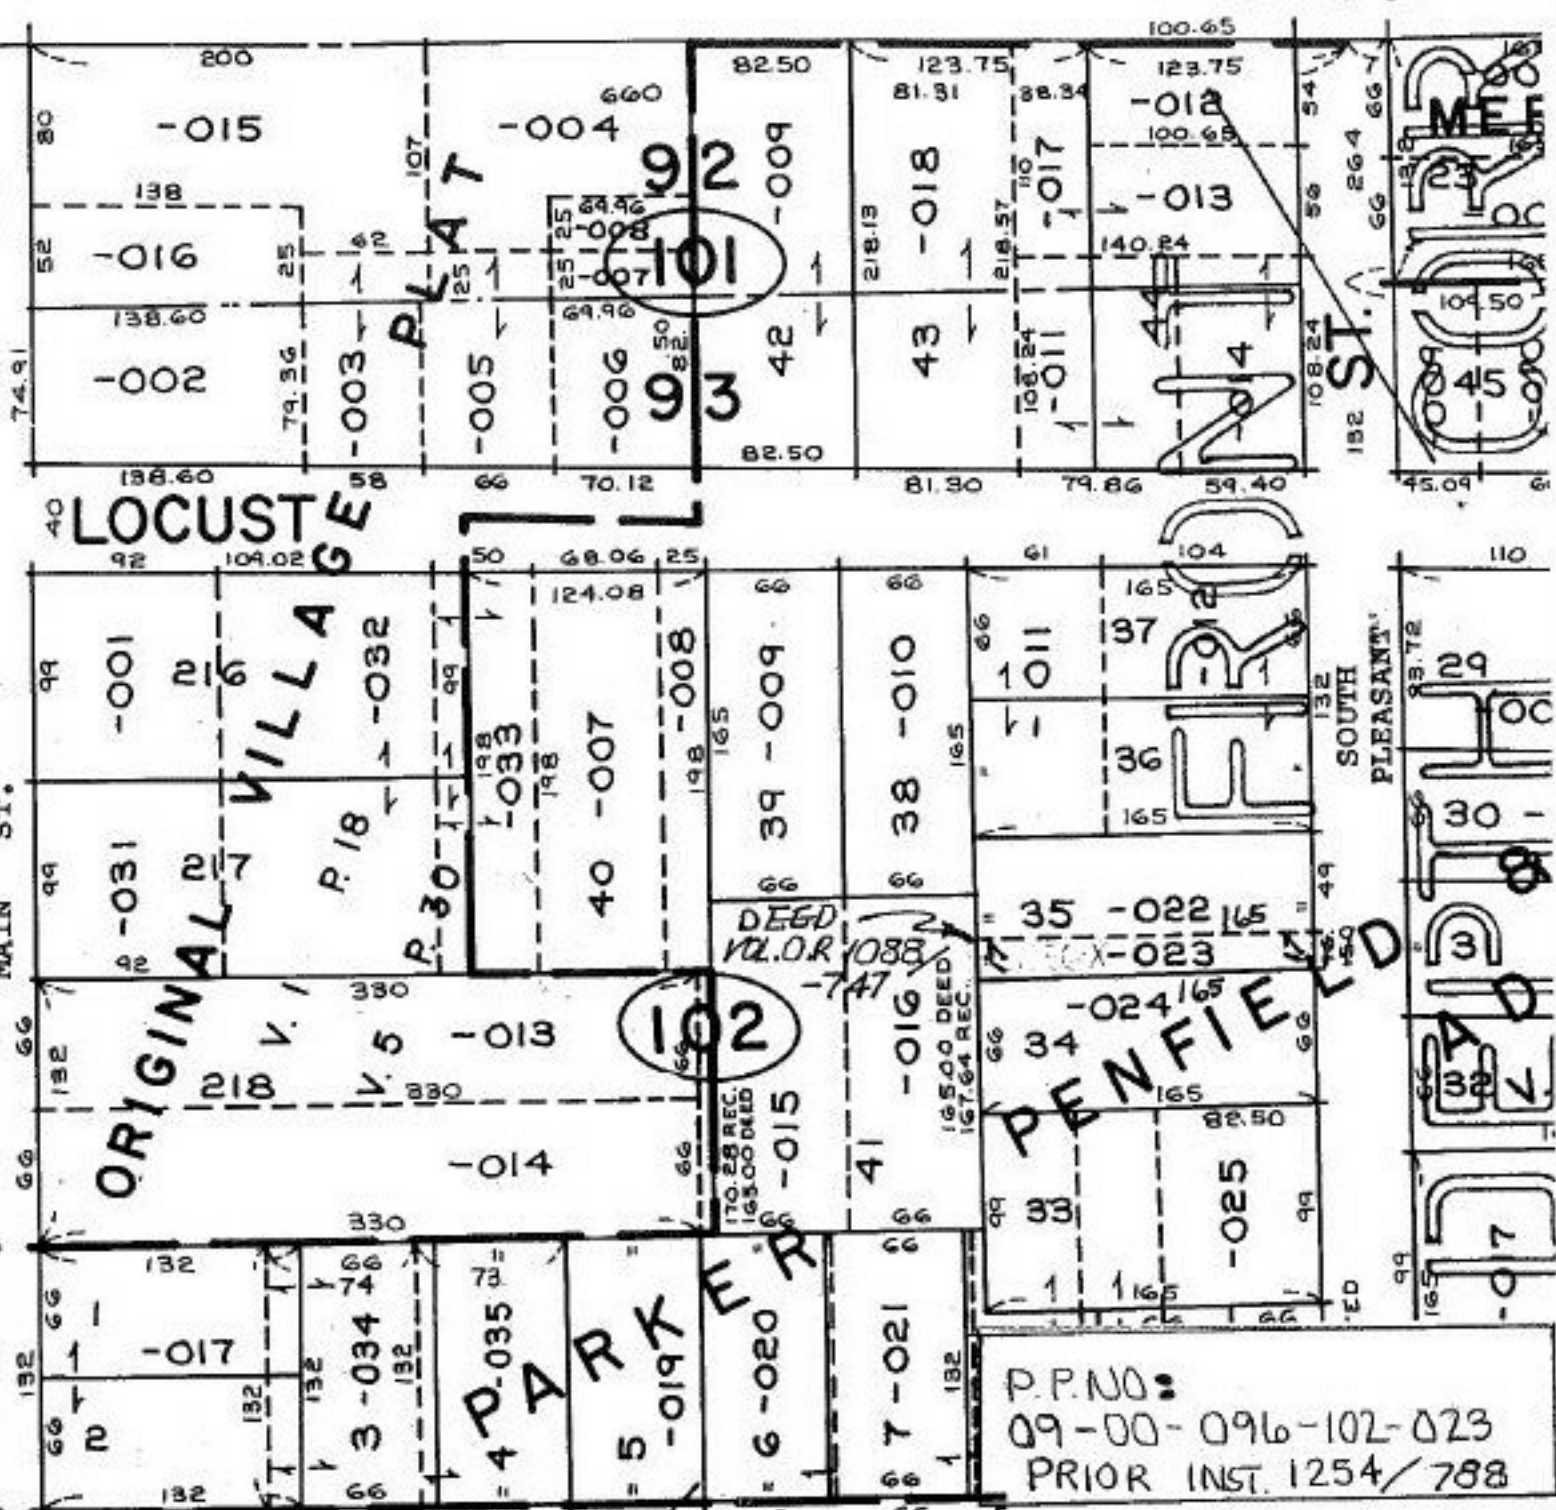

LOCUSTE

ORIGINAL VILLAGE

PARK

PENFIELD

SOUTH PLEASANT

EDISON FRONTAGE / DEPTH CORR.

DER DV. 1254/788 PLAT V. 1 PG. 7
 TO: 09-00-096-102-023C.



P.P. NO:
 09-00-096-102-023
 PRIOR INST. 1254/788

| |
|------------------------------------|
| APPROVED LORAIN CO. MAP DEPT |
| DATE 7-7-95 |
| PAGE 9-00-096 A |
| BY CAROLYN FRANCIS |
| # 21356 |