


**NO CHANGES
OF TAX MAP**

SEE

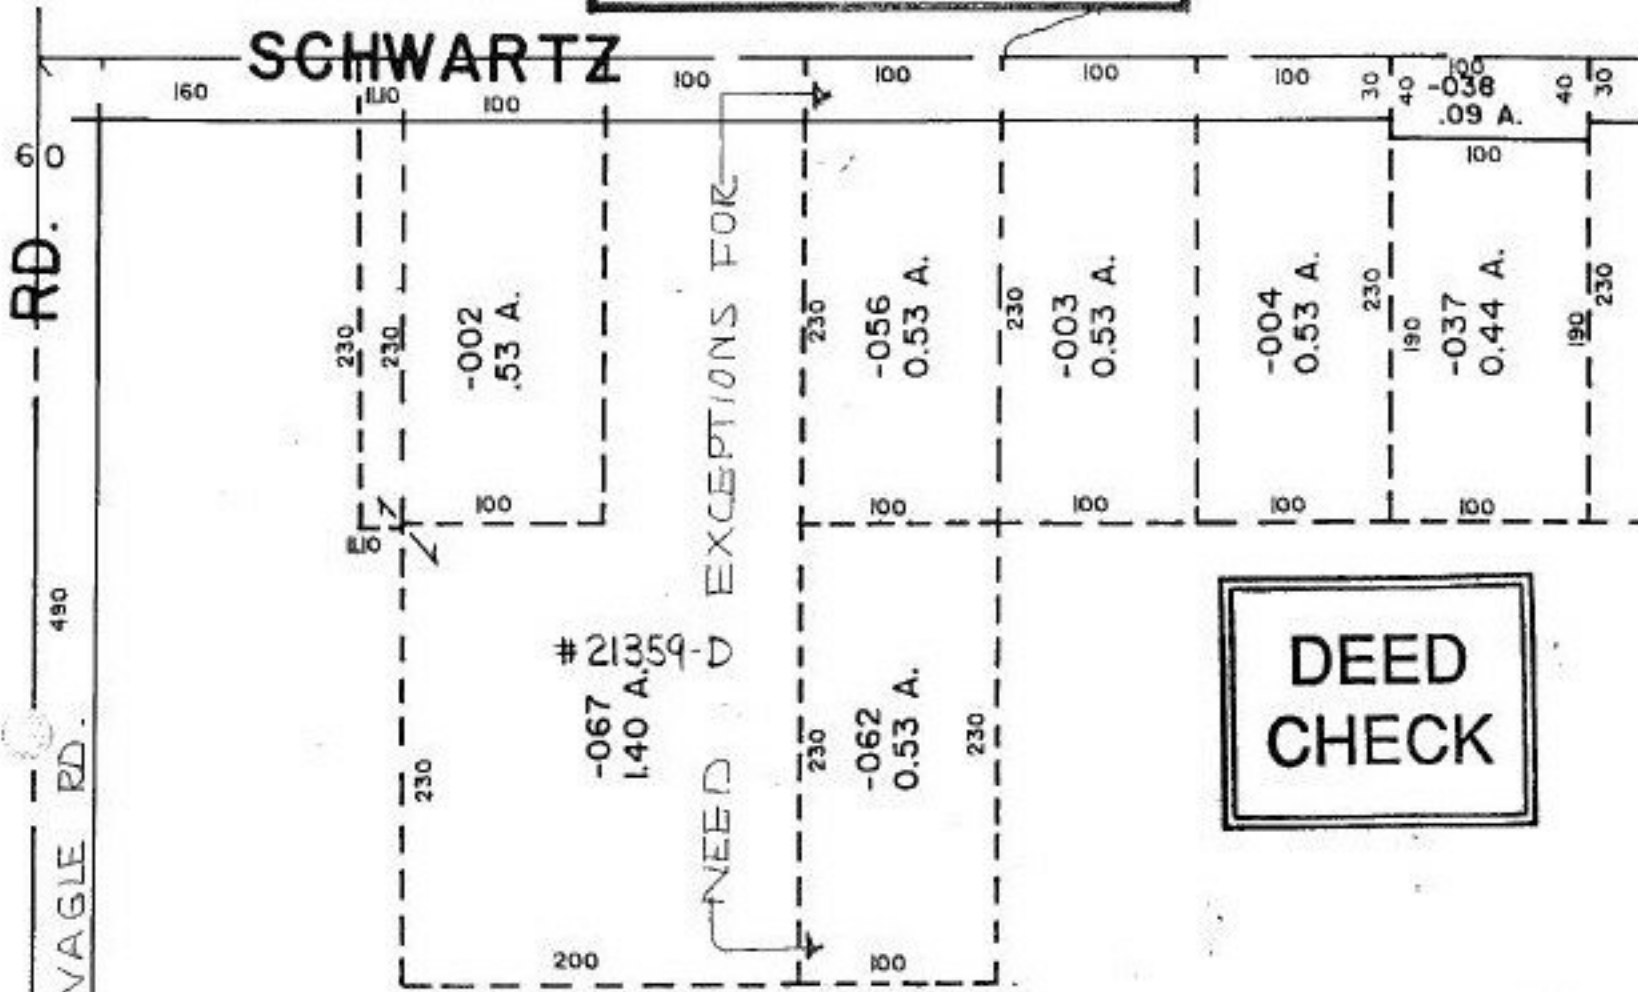

RD. 60
490
LEAR NAGLE RD.

SCHWARTZ

**DEED
CHECK**

PARCELS LEGALS FOR:

- 04-00-026-109-002 OK
- 060 OK
- 070 OK

- 060 - PRIOR INT. O.R. 1058/731
- 002 - O.R. 1051/561
- 070 - O.R. 1069/167
- 067 - 1058/733

21359-D

04-00-026-109-067

NEED EXCEPTIONS FOR

- 04-00-026-109-056 0.53 A.
- 062 0.53 A.

APPROVED LORAIN CO. MAP DEPT
DATE 6-26-95
PAGE 4-00-026-E
BY CAROLYN FRANCIS
21359-D

LEGALS NEED TO STATE ACREAGE
BEING CONVEY FOR
EACH PARCEL.