


SEE SURVEY JOHN POZYWAK P.5592
 CL 1:1INF.
 PRIOR INST REF OR E346, P.152

-007
 50.48 A.

POB JOHN POZYWAK P.5. THIS POINT
 IS "ON" THE NORTH LINE CL 7C

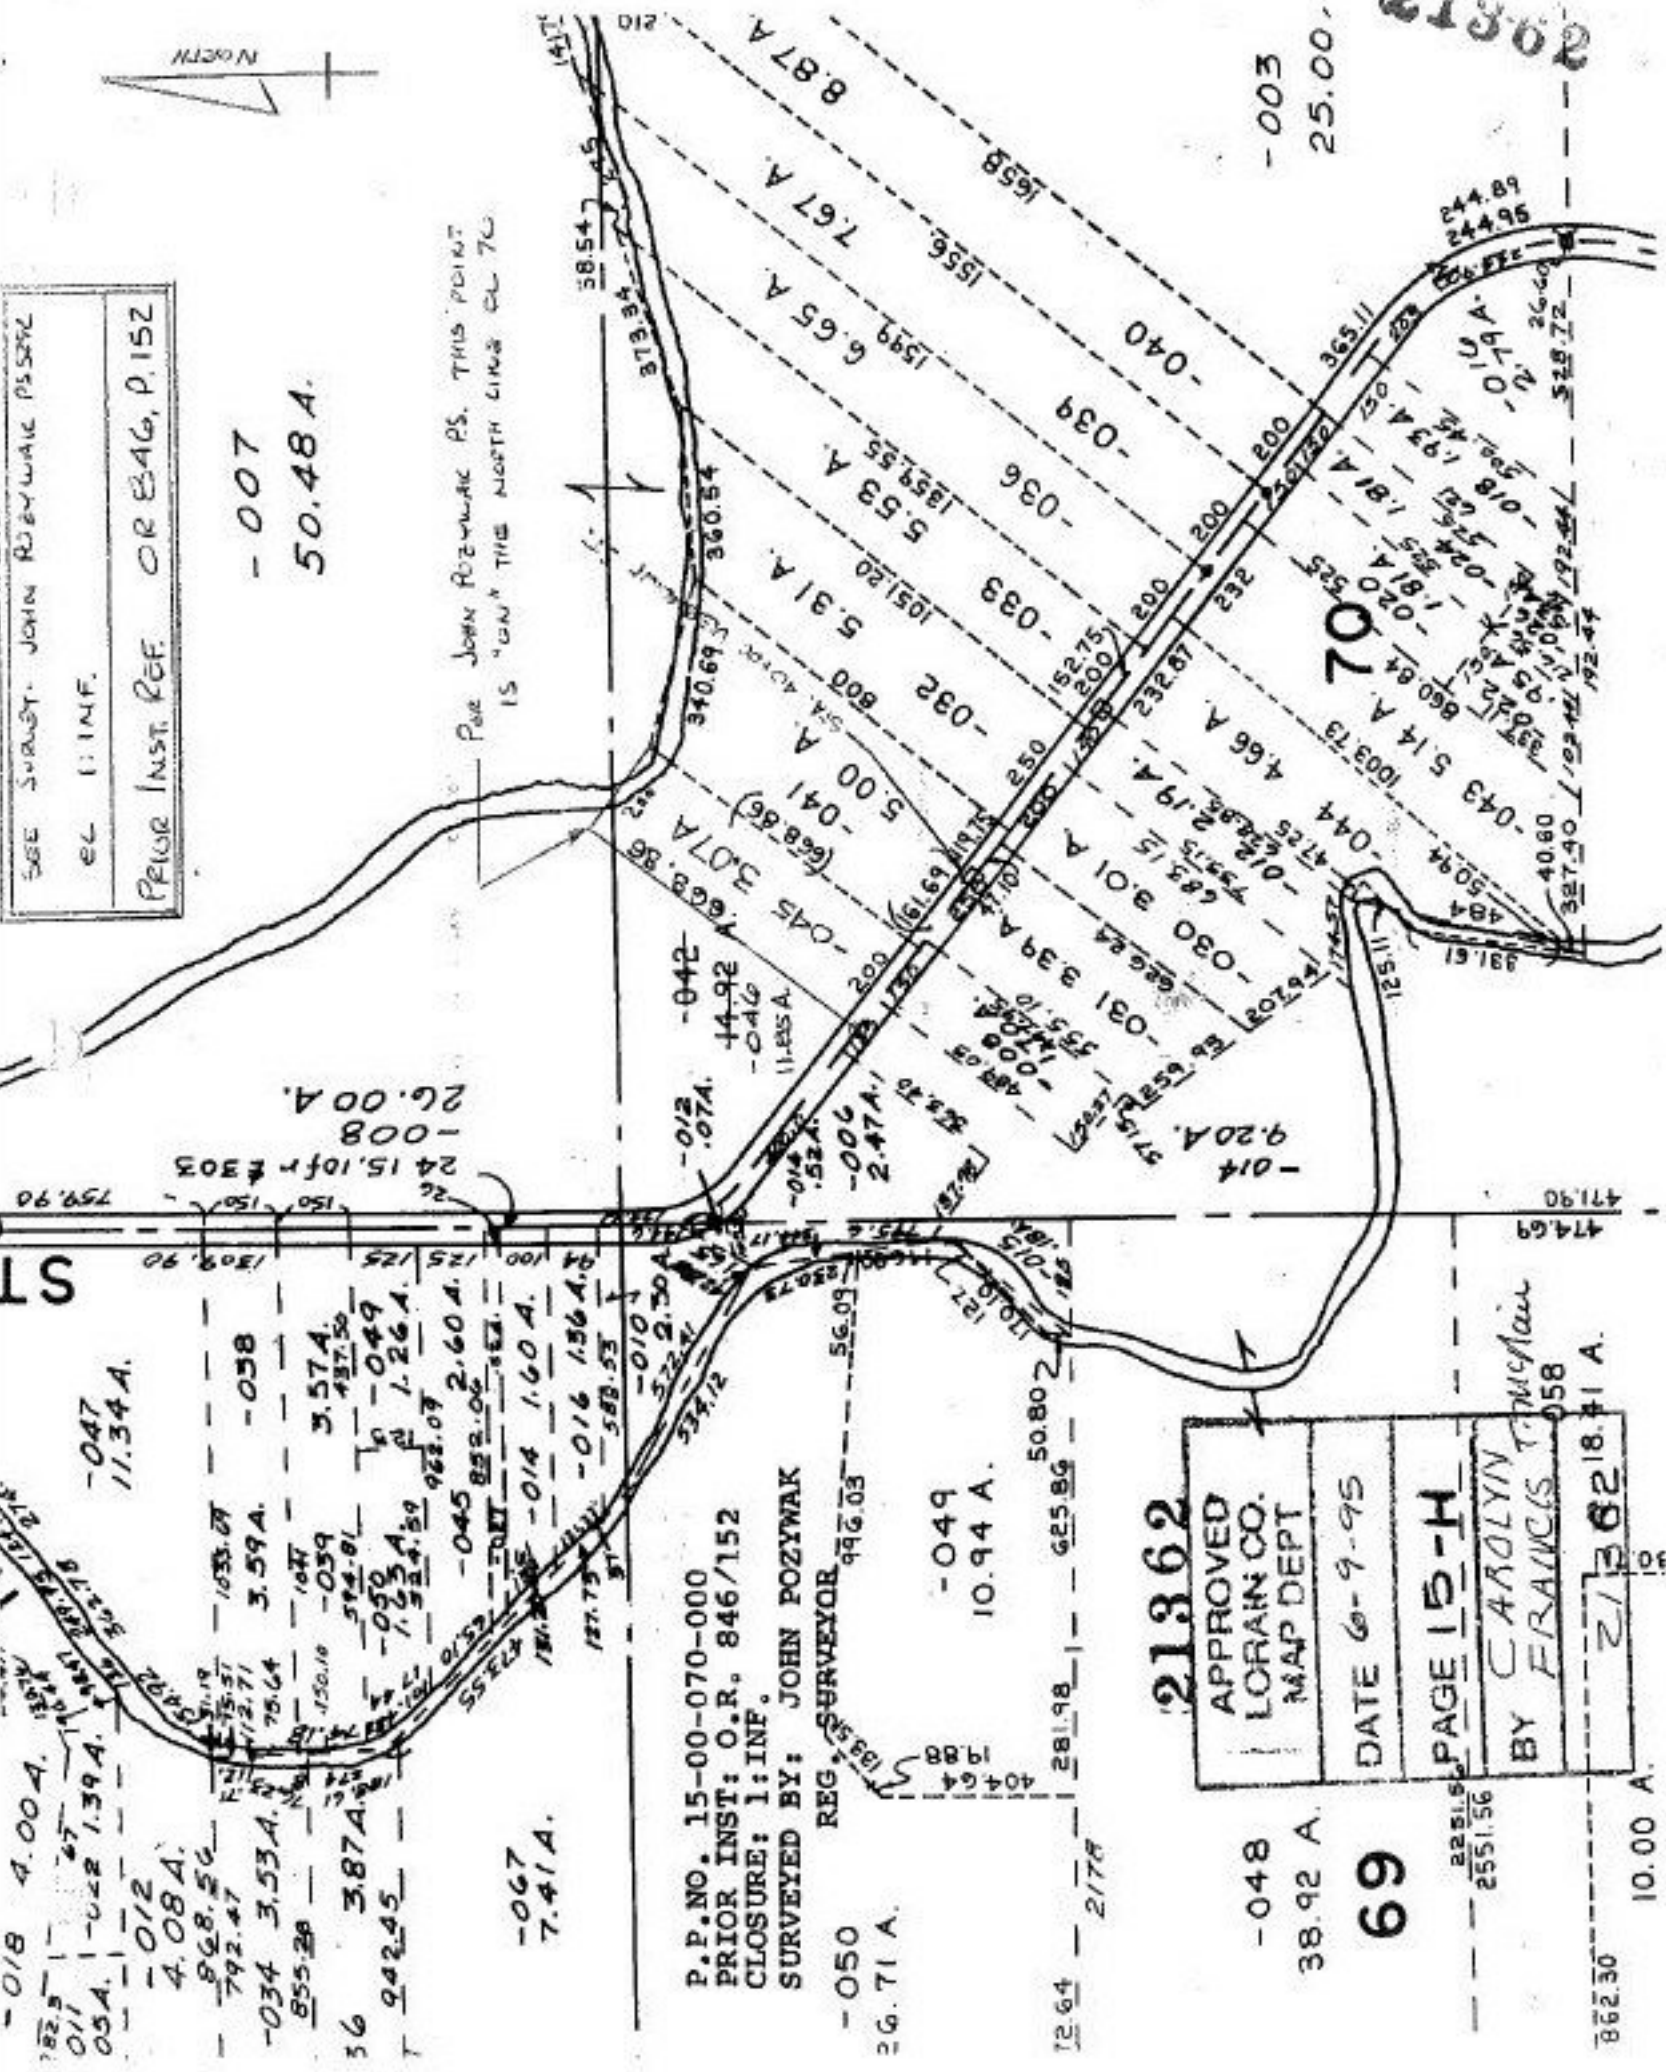

P.P. NO. 15-00-070-000
 PRIOR INST: O.R. 846/152
 CLOSURE: 1:INF.
 SURVEYED BY: JOHN POZYWAK
 REG. SURVEYOR 996.03

21362
 APPROVED
 LORAIN CO.
 MAP DEPT
 DATE 6-9-95
 PAGE 15-H
 BY CAROLYN T. McMain
 FRANCIS 058
 21362.18.41 A.

-048
 38.92 A.
 69

862.30
 10.00 A.

21362

-003
 25.00.