

M O E . 7 1 . 1 0 5

SEE 12-00-036-A

ELYRIA TWINSBURG


RD. 21000

585° 30' E

582.10

585° 30' E

587.91

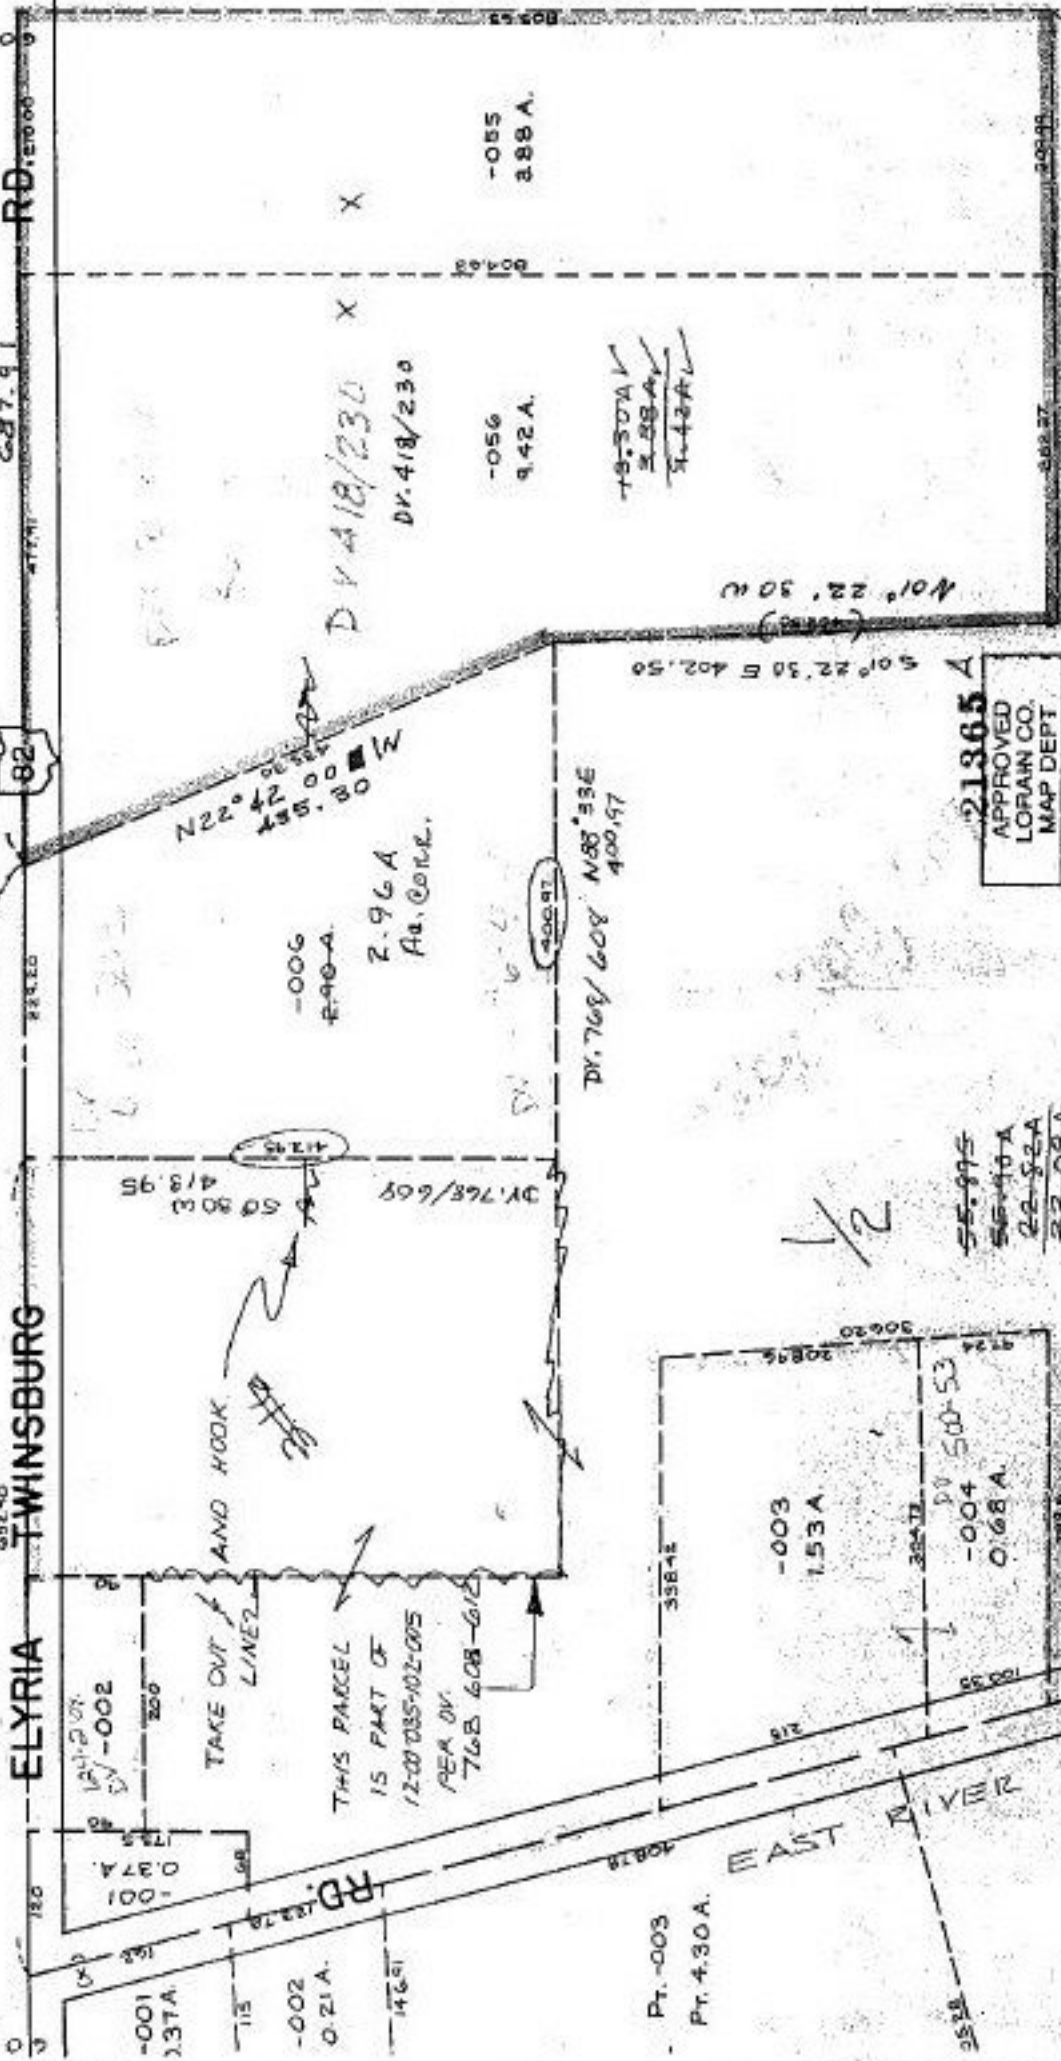

21365 A
APPROVED
LORAIN CO.
MAP DEPT.
DATE 7-13-95
PAGE 12 OF 135 A
BY GAYDON FRANKS
21365-1

MAP CORREL TO 12-00-035-102-005

MAP CORREL

N 89° 12' 30" W 492.36
 S 89° 12' 30" E 492.36

5 0 1 ° 2 2 ' 3 0 " E 4 0 2 . 5 0

N 2 2 ° 4 2 ' 0 0 " W 4 3 3 . 3 0
 0 8 . 5 5 7
 4 2 . 0 0

DR. 768/608 N 88° 33' E 400.97

DR. 418/230

DR. 768/608

TAKE OUT AND HOOK LINE

THIS PARCEL IS PART OF 12-00-035-102-005 AREA DIV. 76B 608-612

EAST RIVER B

Pt. -003
 Pt. 4.30A