


21371

8/15/95
THIS PLAT RE-SUBMITTED
WITH PLAT # 21428
ON ~~8/15/95~~ TICKET # 724195 BY LCTC
L. MURRAY
ORIGINAL SUBMISSION WAS ONCE
A PRELIMINARY COPY
W/ NO FEE Pd.

* EAST HAMPTON SUB. NO. 5
SEE - RE-SUBMIT

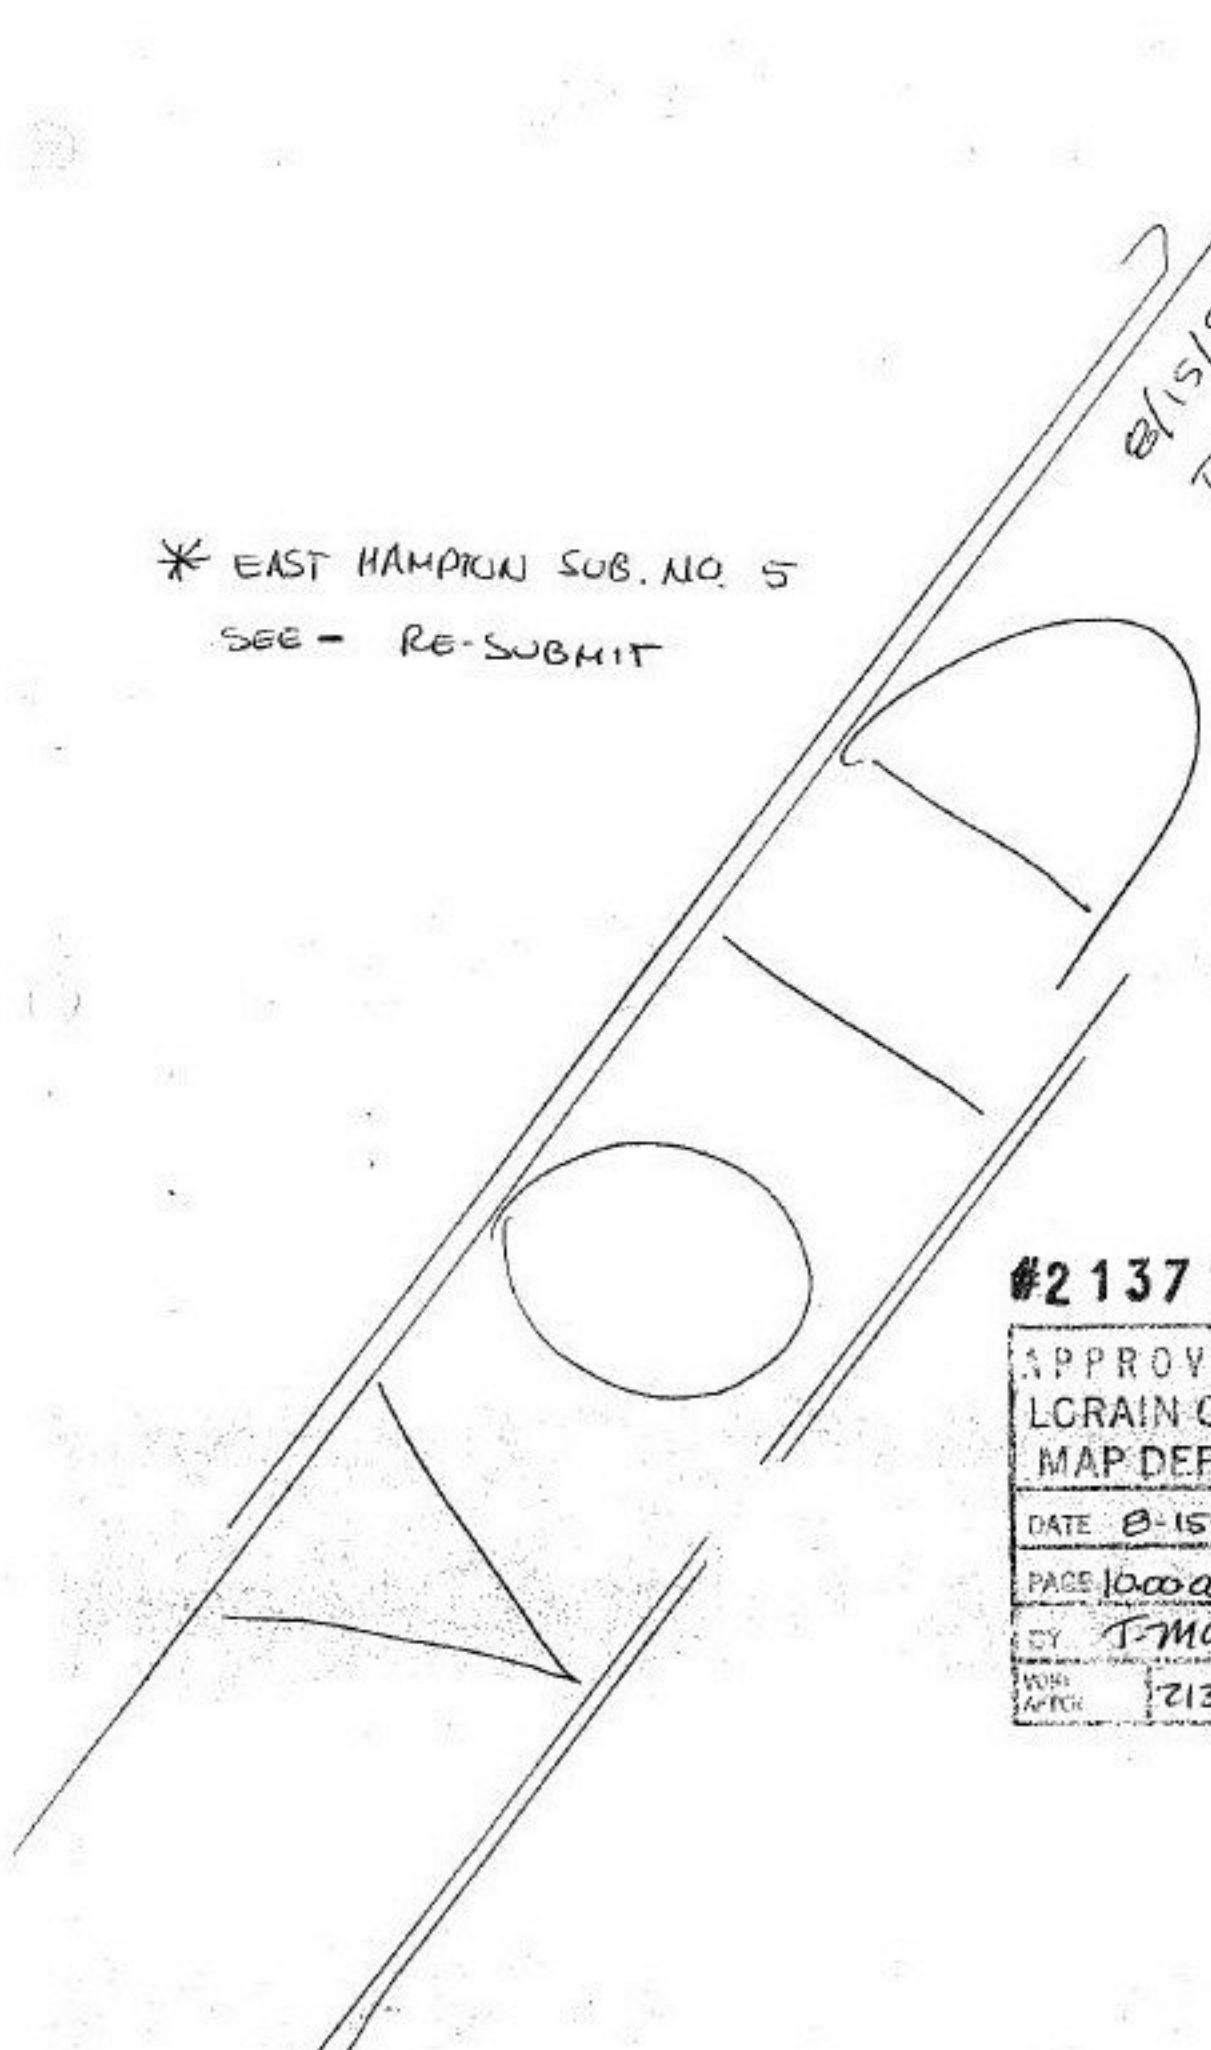

#21371

APPROVED	
LCRAIN CO.	
MAP DEPT.	
DATE	8-15-95
PAGE	1000005-0
BY	J-McNair
WORK APPRO	21371