

21370-0

AC. CORR. ~~15.43A~~  
ER SURVEY BY  
F. MACCALLUM  
EG. SURVEYOR  
WILL REST  
PARCEL # 2  
7.76A.

-020  
5.00 A. DUP. #1  
3.00 A. DUP. #2 (50.00)  
8.00 A. TOTAL  
16.00 A. OLD MAP  
15.60 A. PL.

7.67A

**NO CHANGES  
OF TAX MAP**  
PARCEL #1


106

458.54

CORR. TO REG. ONLY

REG. SHOWED - 021 AS 3.00 A  
FRONTAGES FOR 021 THRU 025  
HAD TO BE CORR. IN REG.

180.54 180.21 430.45 250

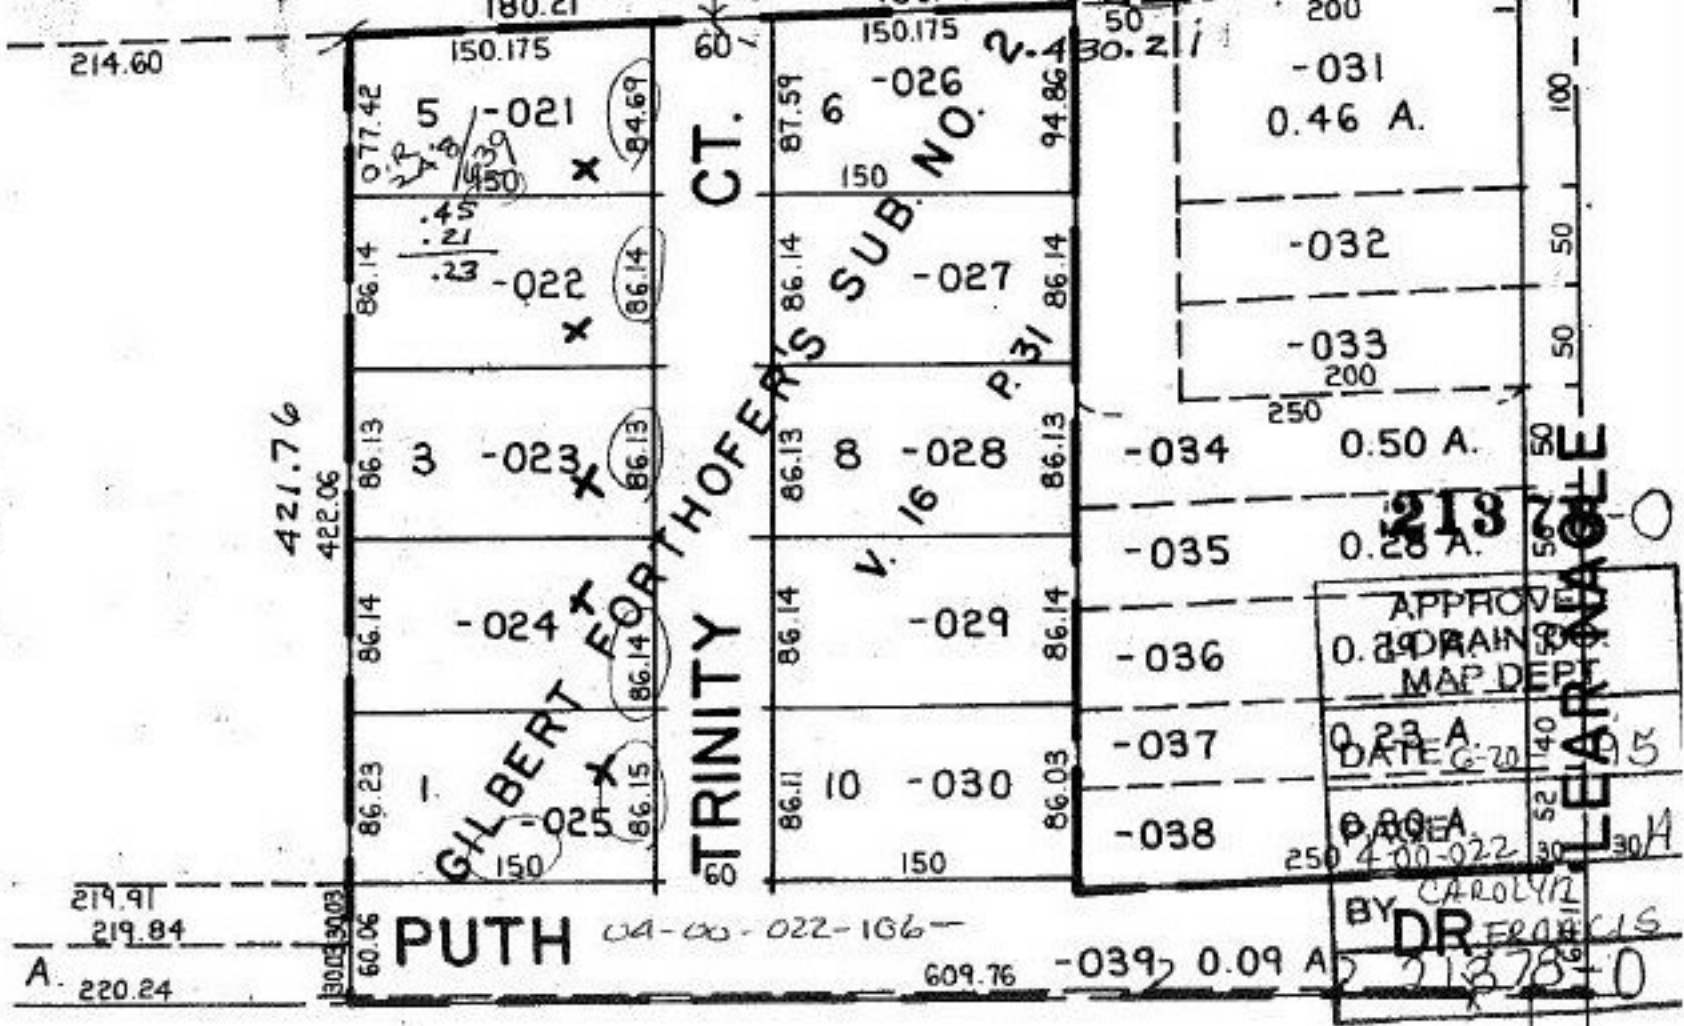

APPROVE  
O. B. DRAIN  
MAP DEPT.  
DATE 6-20-85  
BY CAROLYN  
DR. FRANCIS  
21378-0