


21381X

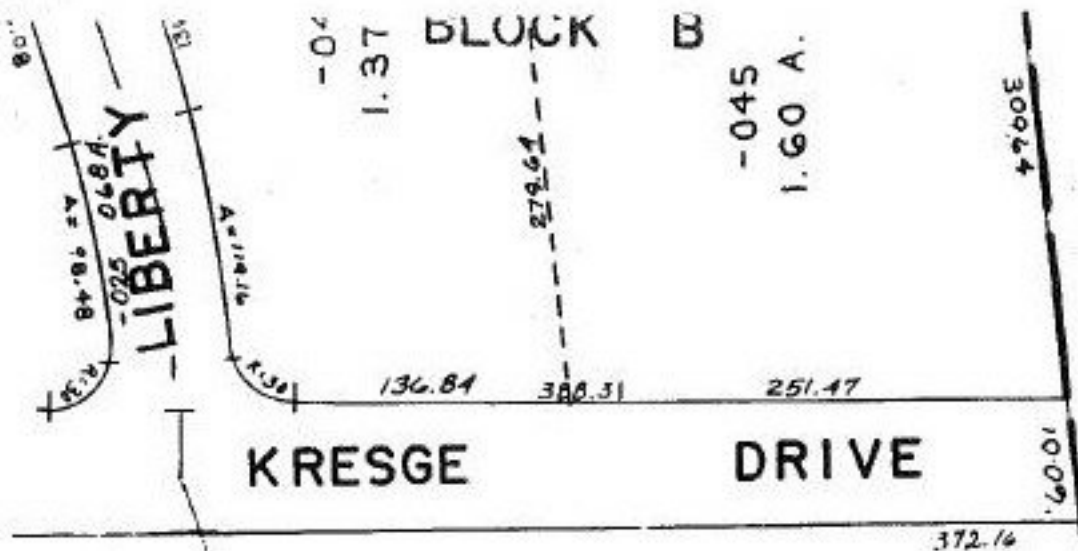

-032
 9.50
 SPLIT for
 purposes
 without
 10-4-

-033
 PT. BLOCK D
 10.14 A.

Pt. -052
 Pt. 9.41 Ac.


2 ACREAGE
 CORRECTIONS

SEE
 CERT. OF CORRECT.

#21381-X

APPROVED LORAIN CO. MAP DEPT.	
DATE 6-20-45	
PAGE 5-00-041-B	
BY T. McKim	
VOID AFTER	21381-X

SEE 5-00-041-A

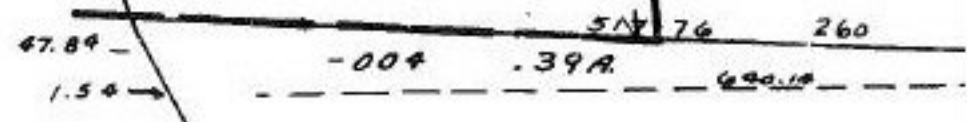

5-00-041-B