


21382-D

SEE 20-05-022-B

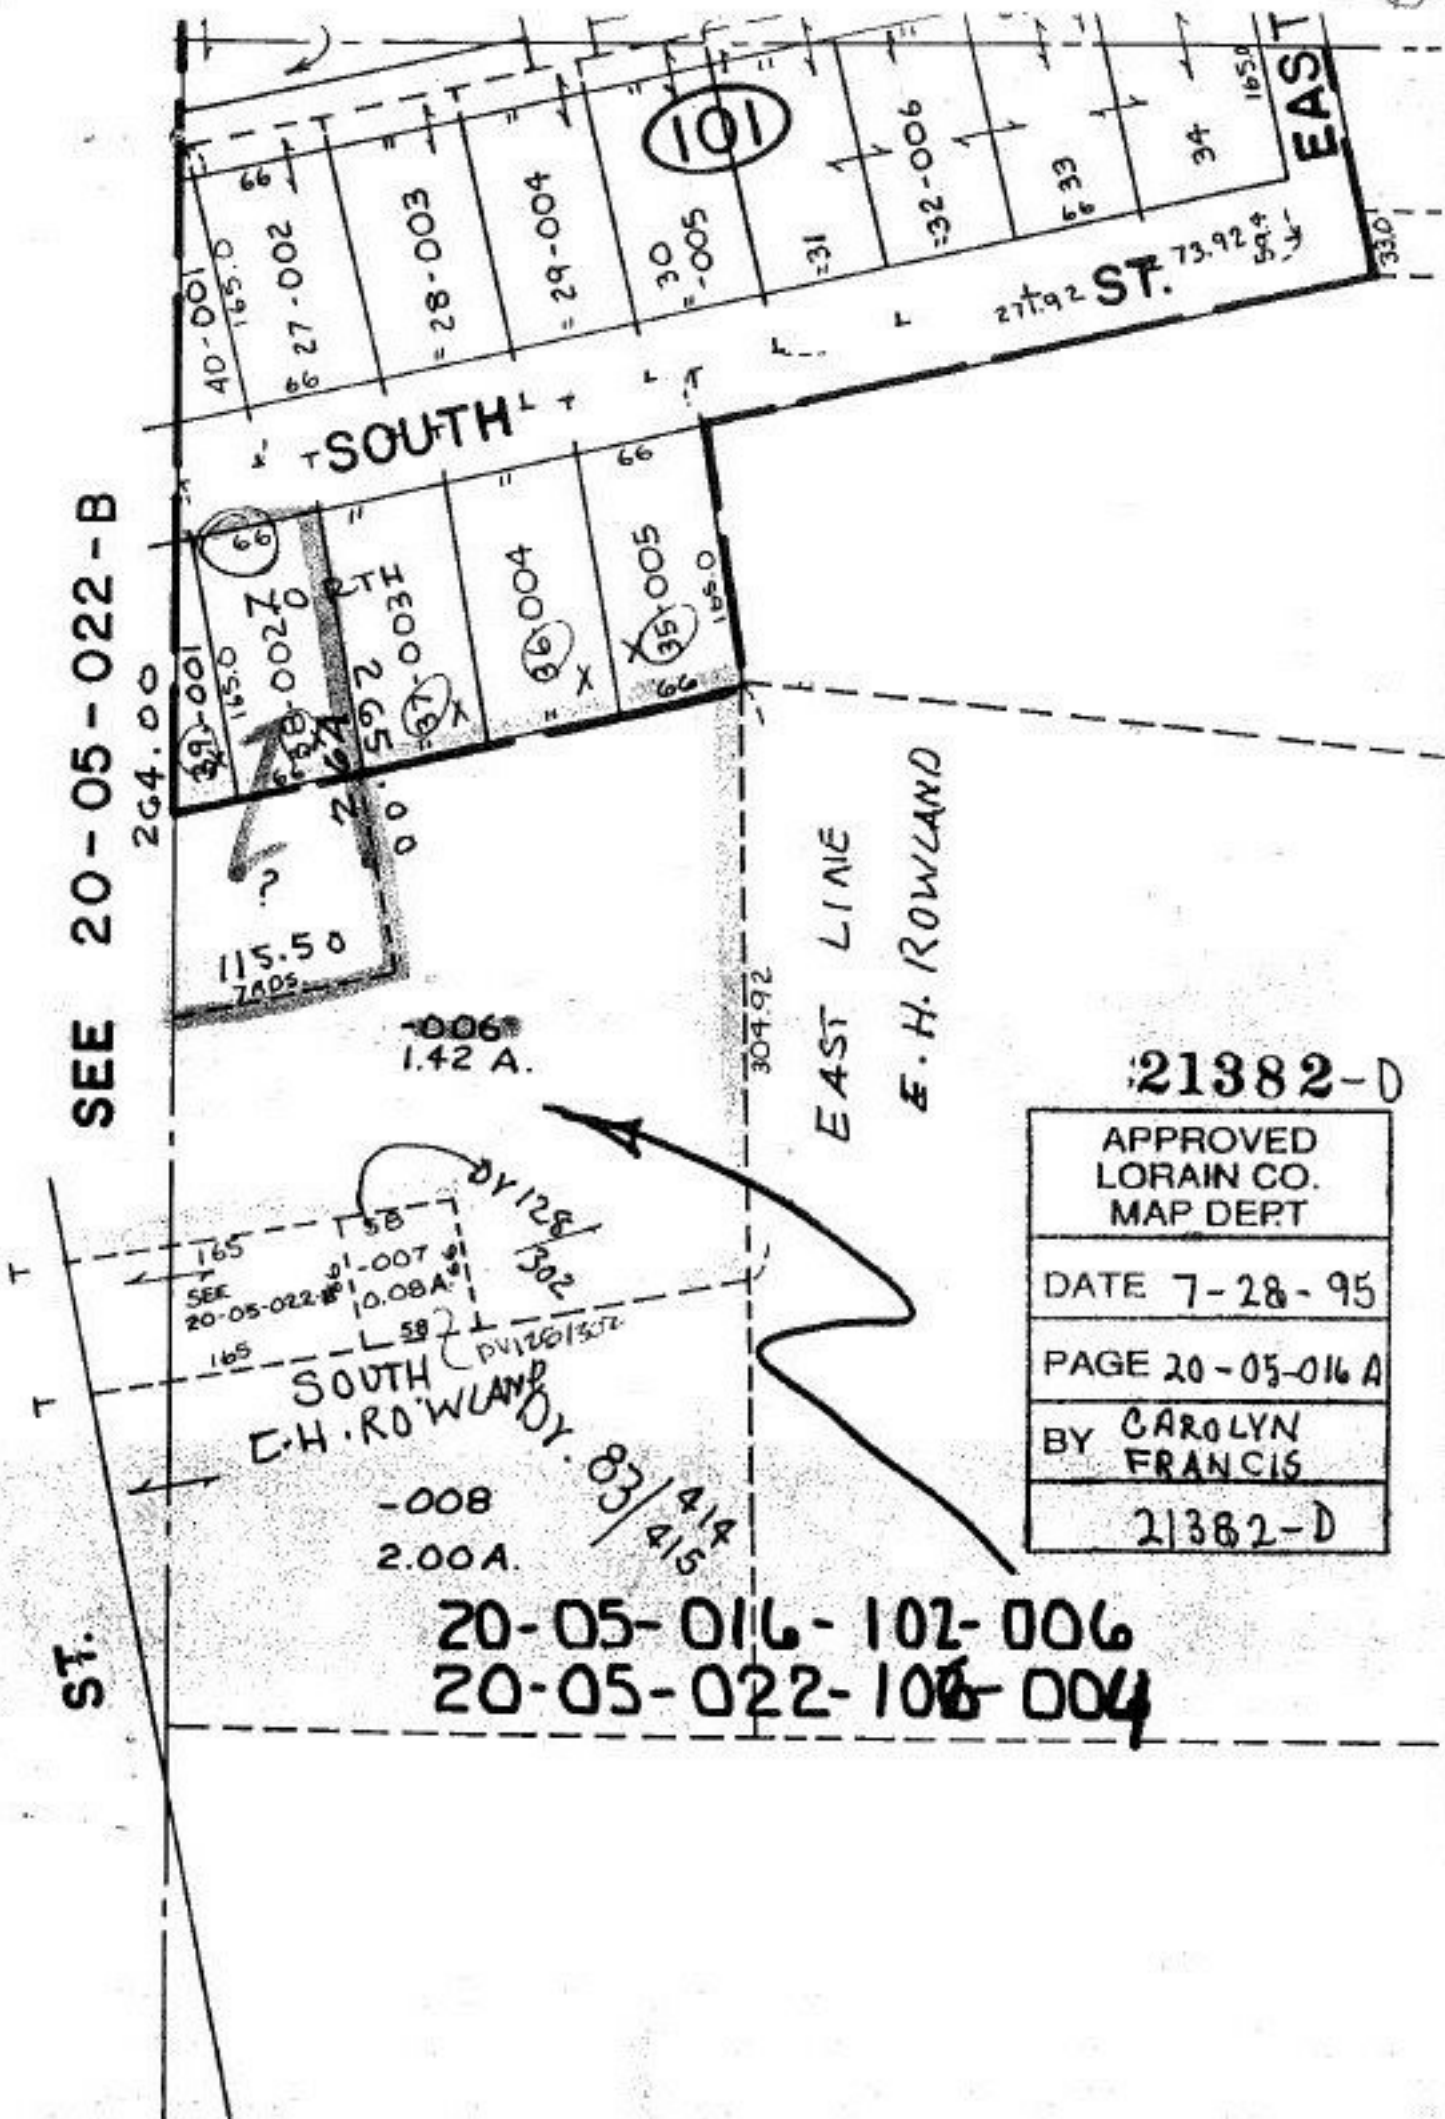

21382-D

APPROVED LORAIN CO. MAP DEPT
DATE 7-28-95
PAGE 20-05-016 A
BY CAROLYN FRANCIS
21382-D

20-05-016-102-006
 20-05-022-108-004