


WHEELER V.I.P.C.

#21382-D

SEE 20-05-017-A

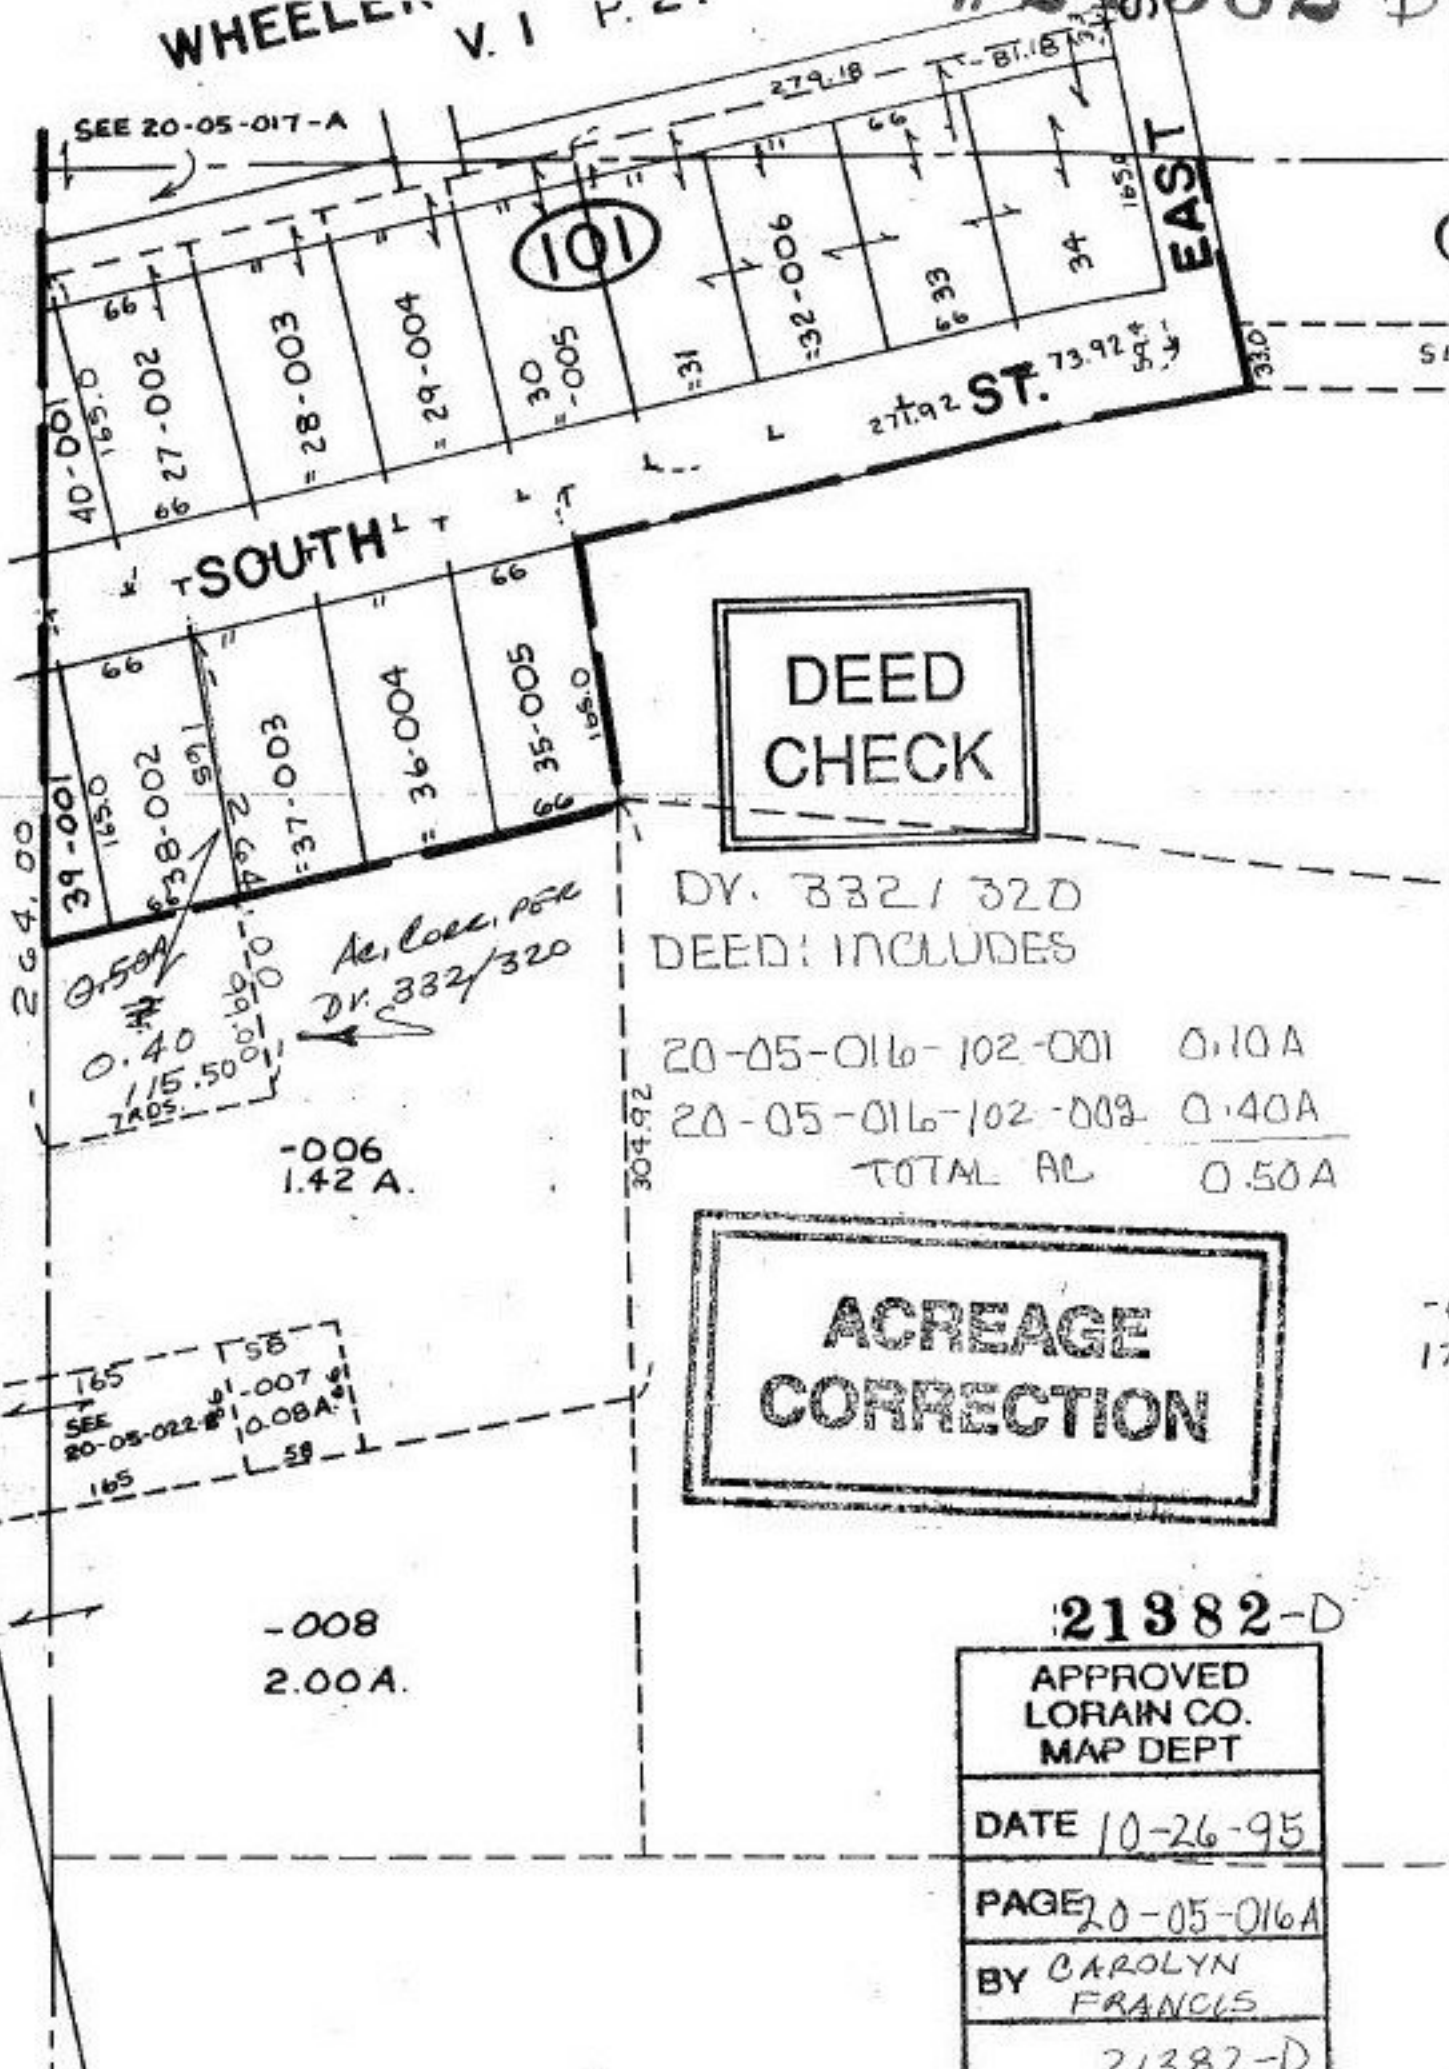

DEED CHECK

Dr. 332 / 320
DEED INCLUDES

20-05-016-102-001	0.10A
20-05-016-102-002	0.40A
TOTAL AC	
	0.50A

ACREAGE CORRECTION

-006
1.42 A.

-008
2.00 A.

SEE 20-05-022-B
0.08A
58
59

SEE 20-05-022-B

ST.

21382-D

APPROVED LORAIN CO. MAP DEPT
DATE 10-26-95
PAGE 20-05-016A
BY CAROLYN FRANCIS
21382-D