

21392

12.46 A.

HAMPTON

BEGINNING IN THE CENTERLINE OF ABBE RD
AT ITS INTERSECTION BETWEEN CARLISLE TWP.
AND ELYRIA TWP. THENCE SOUTH 798.34 ft.

- 281 0.65 A
SPUT INTO: 900-046-0.13 A

-001
0.44 A.

-019
0.44 A.

149.99
143.99
-338
-339
0.27A
0.24A

-336
0.26 A.

-337
0.26 A.

-263
1.67 A.

-003
1.54 A.

-004
1.54 A.


EAST HAMPTON SUB
PV. 52 P. 57, 58 #2

P.P.NO. 10-00-005-10
P.P.NO. 10-00-005-900
PRIOR INST: DV. 1285/
479
CLOSURE: .14ac.
0.08:10,000
0.27ac. 0.29:10,000
0.24ac. 1:INF.
SURVEYED BY: DAVID L.
ELWELL REG. SURVEYOR

21392

APPROVED
LORAIN CO.
MAP DEPT
DATE 6-30-95
PAGE 10-00-005-C
BY CAROLYN
FRANCIS
21392

E 10-00-005-B
ABBE RD.

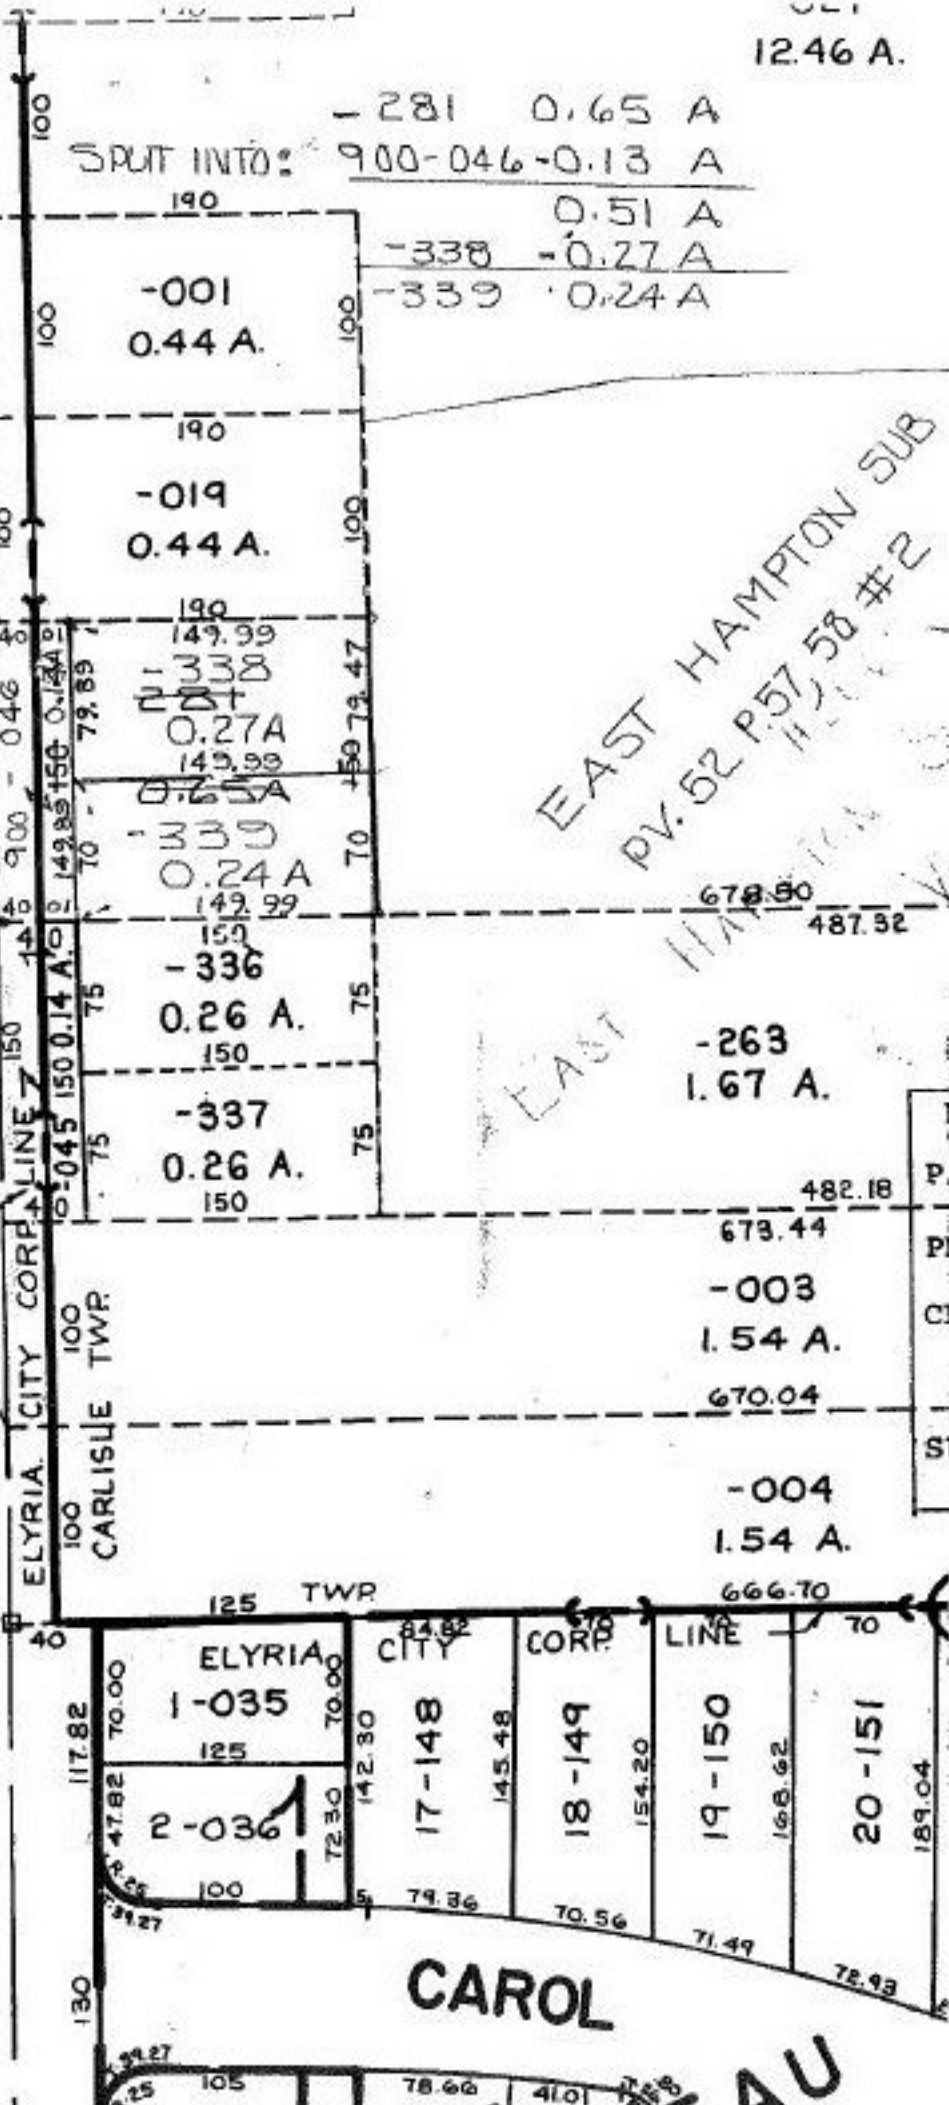

CAROL

AU