


#21407-D

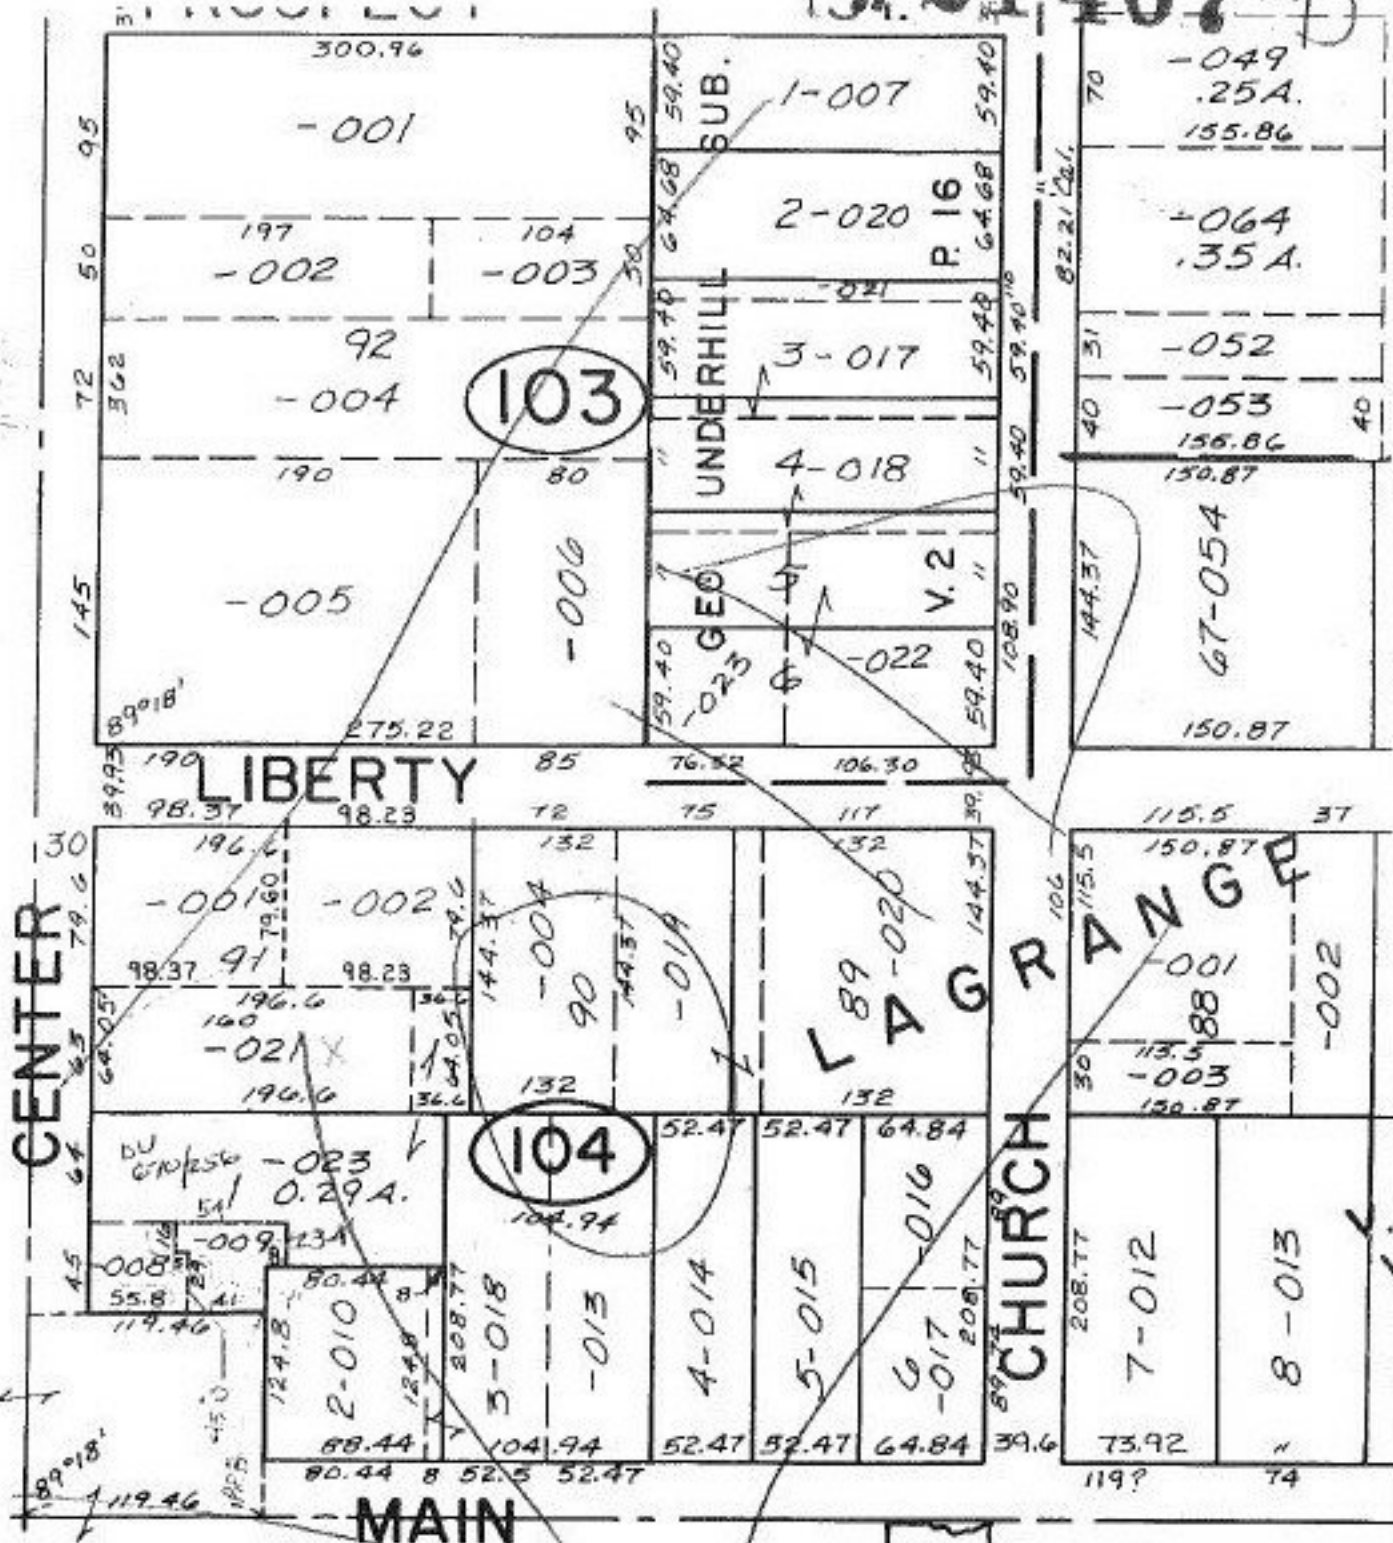

5/18/95
10/13/95

10/13/95

5-000 10-10

CENTER

LIBERTY

UNDERHILL

GEO.

CHURCH

RANGE

MAIN

303

SEE 15-00
#21407-D

-009 DW 1186/136-

PLS FOR W/ST PART DV 95, PG 2

RENUMBERED DUE TO
TIME TO PROCESS
SEE #22495-D
dated 6-24-98

009: 0.11A

(41X 45 INTEG.)
DV 6-70 P. 256-

PARCEL SIZE
CORRECTION

ACRNG TO FIRST
DEATH

APPROVED
LORAIN CO
MAY SEP
11/20/96
15-00046 A
T. McNamee
JOO 200
21407-D