


S CENTERLINE INTERSECTION OF STATION ROAD AND ALSO THE WESTERLY LINE OF LOT NO. 62. THENCE 1333.00 ft. to place of BEGINNING

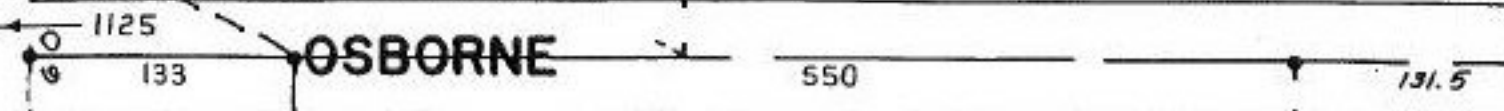

OSBORNE

# COMBINATION

12-00-062-000-053	1.10A
<del>-055</del>	1.42A
<del>-057</del>	2.52A

360  
-053  
2.52A  
+1.10A  
360

-056  
-054  
8.70A  
7.28A

379

100A  
-009  
C.C.C.

Presser  
172/886

514.00  
-055  
+1.42A  
416.65

500

164  
Pt. 1.00  
Pt. 15.7

648 682.20  
ST. L.  
C.C.C.

P.P.NO. 12-00-062-000  
PRIOR INST: 1062/792  
CLOSURE: 6.04:10,000  
SURVEYED BY: RONALD D. ROBISON REG. SURV.

21429  
APPROVED  
LORAIN CO.  
MAP DEPT  
DATE 7-28-95  
PAGE 12-00-062-B  
BY CAROLYN FRANCIS

8.70 A  
1.42 A  
7.28 A

SPLIT