



21431

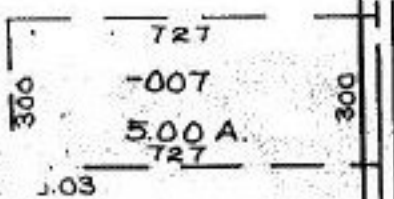

-001  
50.00 A.

SPLIT  
OUT OF 023  
10.63A  
005 SPLIT 1.46A  
10.02 A REM: 9.17A

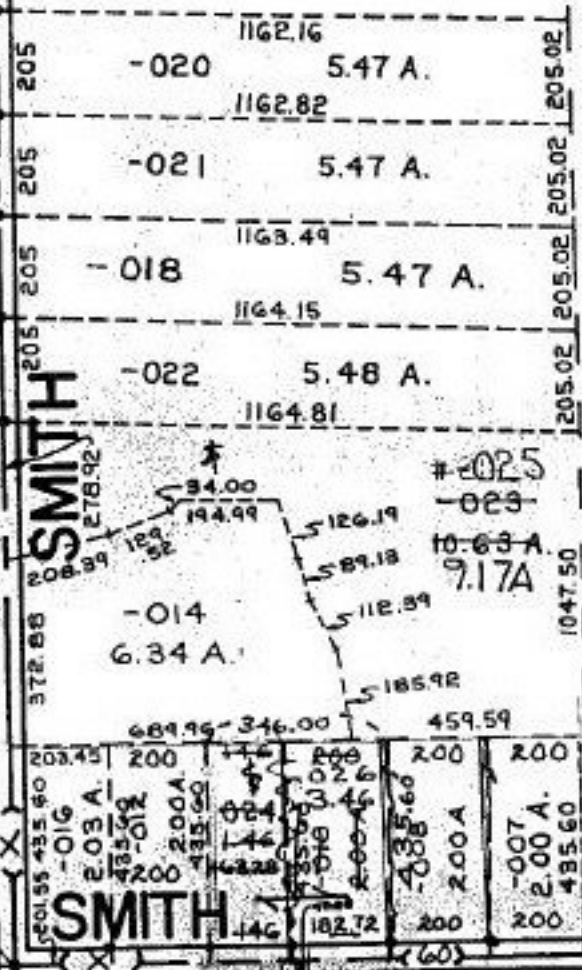

-006  
99.00 A.

COMBINATION  
# -024 1.46A  
010 2.00A  
TOTAL 3.46A  
-006  
32.98 A.

21431

APPROVED LORAIN CO. MAP DEPT
DATE 8-1-95
PAGE 18-H
BY CAROLYN FRANCIS
# 21431

SPLIT / COMBINATION

SEE 21-D

P.P. NO. 18-00-001-000  
PRIOR INST: O.R. 573/387  
CLOSURE: 1: INF.  
SURVEYED BY: WILLIAM FOX  
REG. SURVEYOR

DETAIL NOT TO SCALE"

W/D