


-OUT
43.00 A.

800

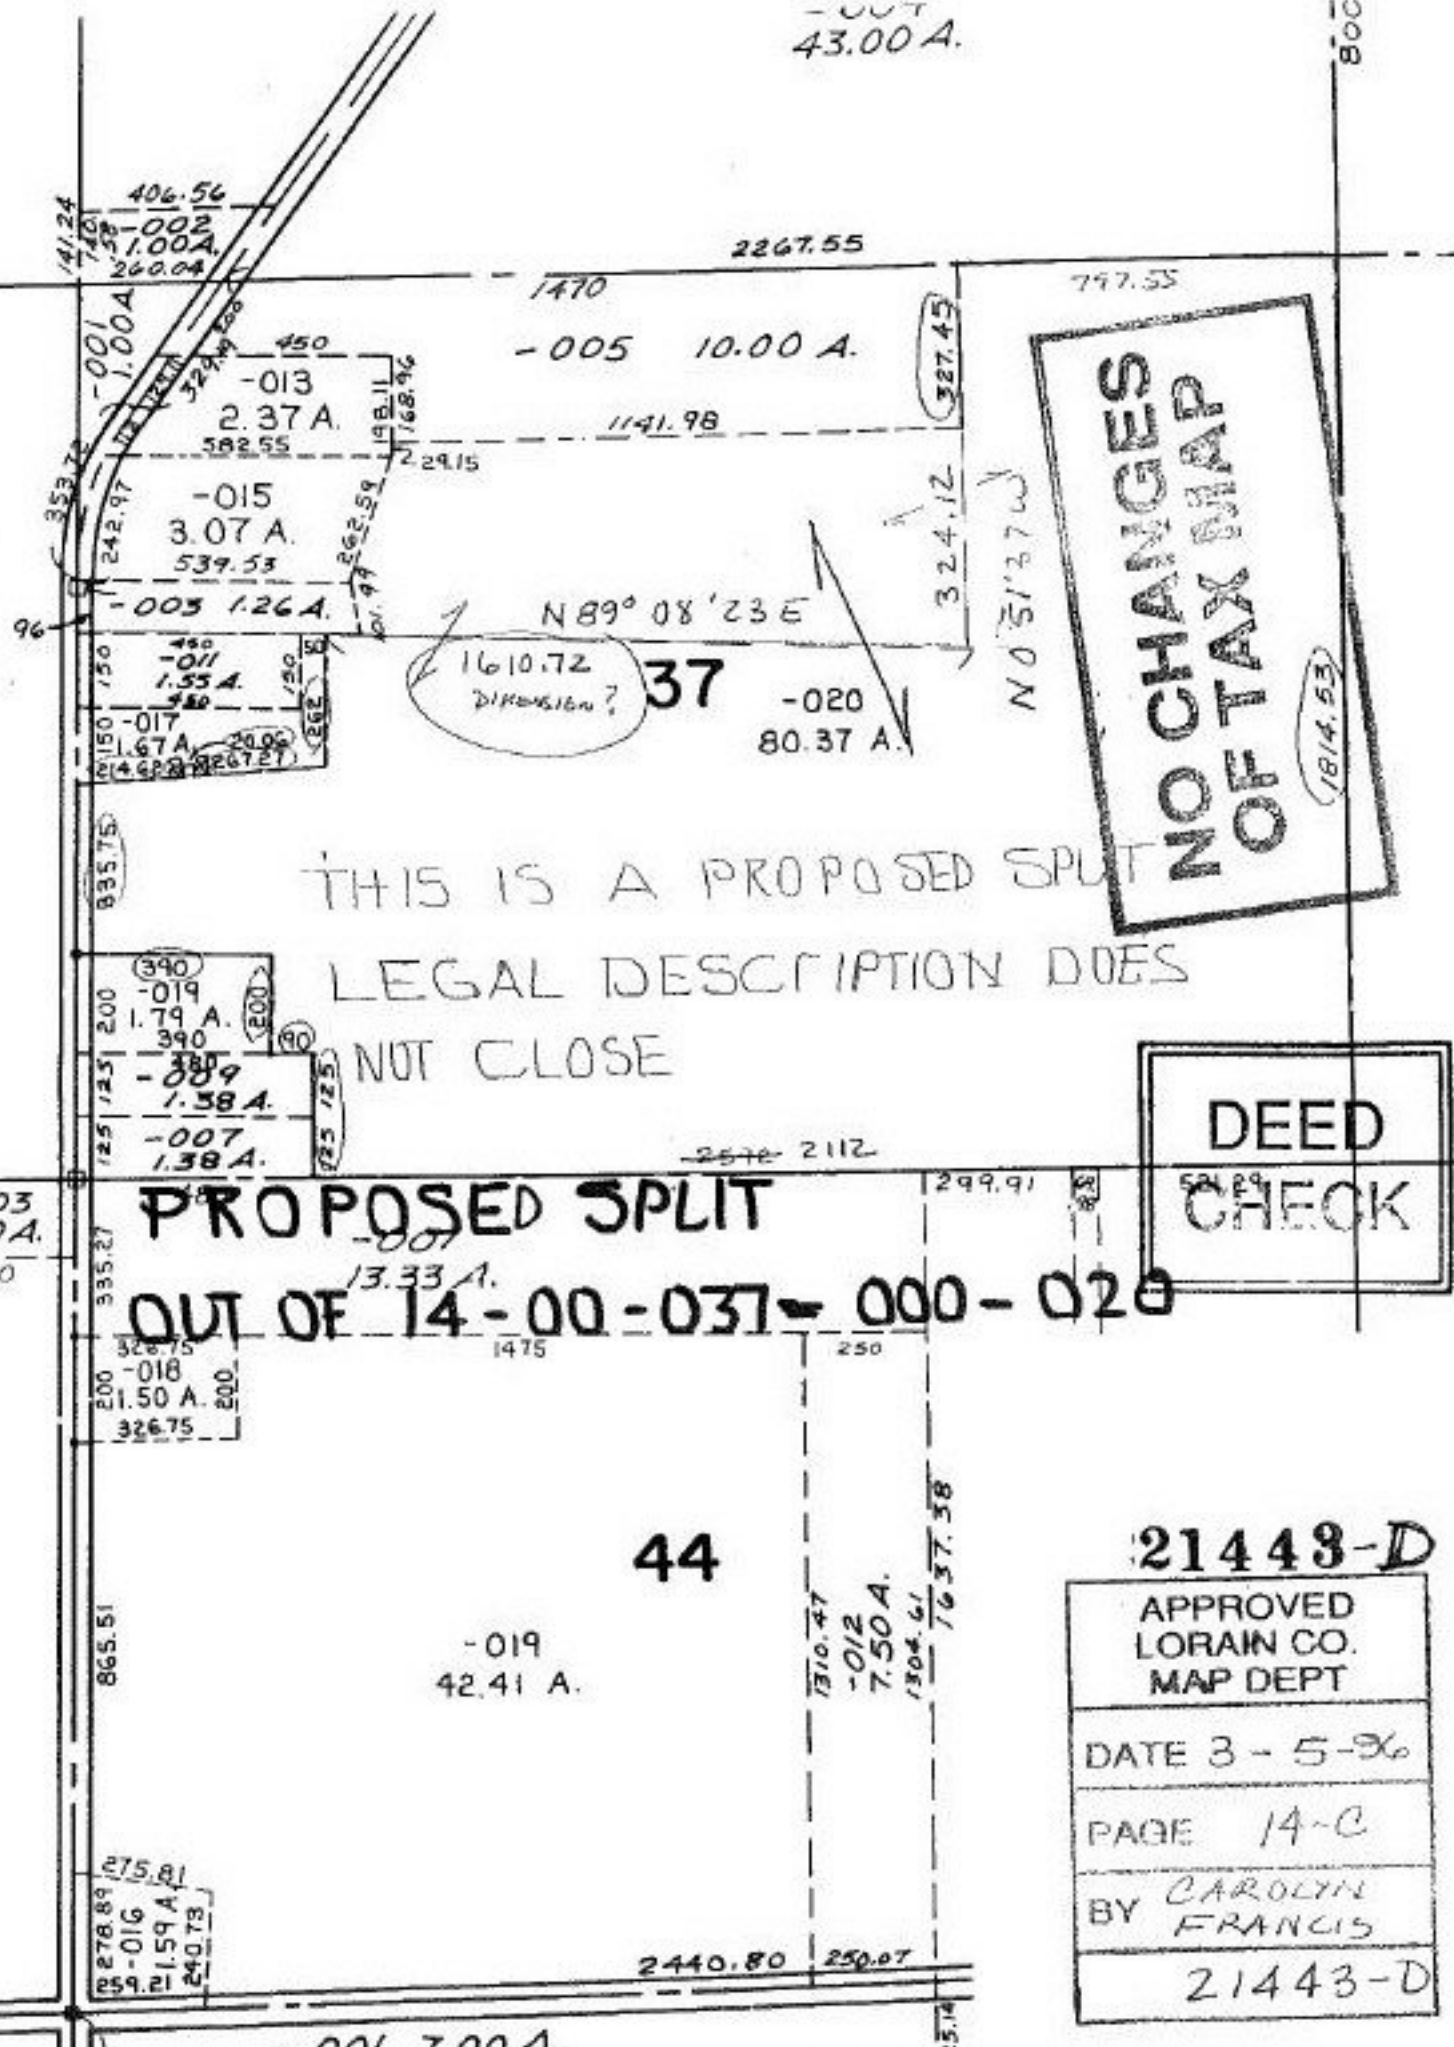

**NO CHANGES
OF TAX MAP**

1814.53

THIS IS A PROPOSED SPLIT
LEGAL DESCRIPTION DOES
NOT CLOSE

**DEED
CHECK**

PROPOSED SPLIT
OUT OF 14-00-037-000-020

21443-D

APPROVED
LORAIN CO.
MAP DEPT

DATE 3-5-96

PAGE 14-C

BY CAROLYN
FRANCIS

21443-D

518.24
-009

-001 7.00 A.

2440.80 250.07

225.14