


Pg. 6-123

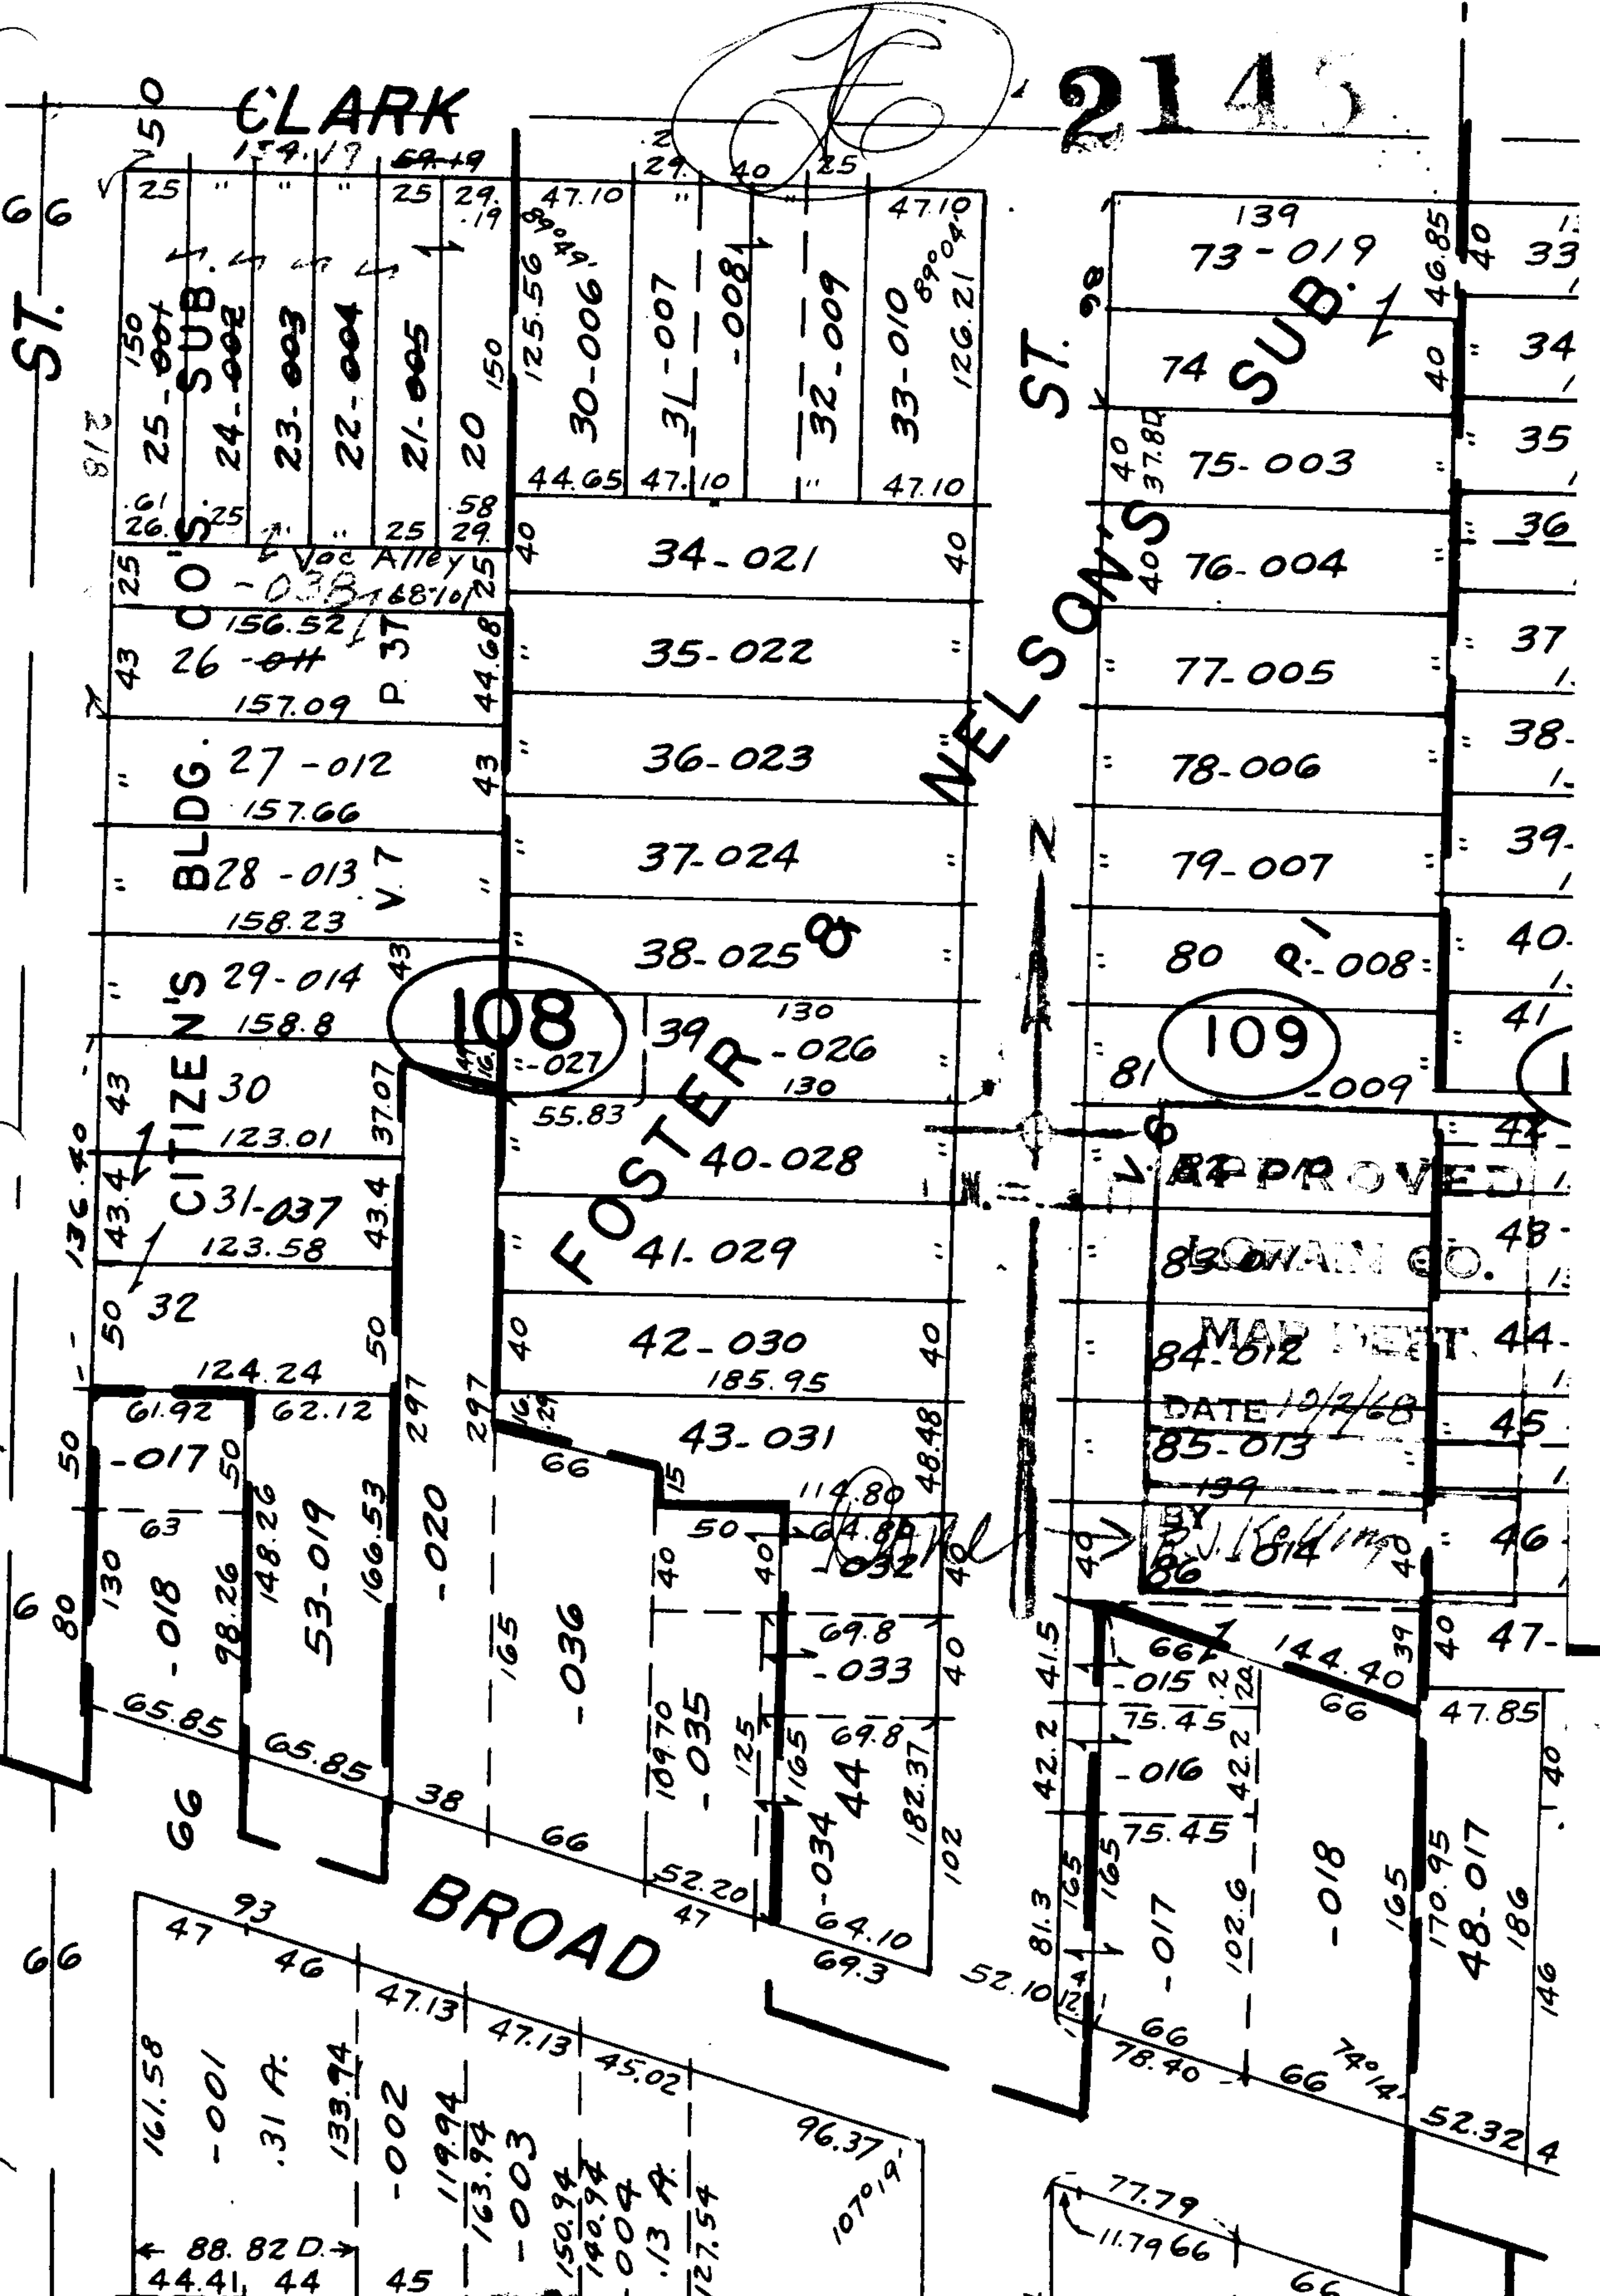

CLARK

2145

Lot No.	Area/Value	Notes
25	26.25	150 SUB
26	156.52	150 SUB
27	157.09	150 SUB
28	158.23	150 SUB
29	158.8	150 SUB
30	123.01	150 SUB
31	123.58	150 SUB
32	124.24	150 SUB
33	47.10	150 SUB
34	44.65	150 SUB
35	47.10	150 SUB
36	47.10	150 SUB
37	47.10	150 SUB
38	47.10	150 SUB
39	55.83	150 SUB
40	185.95	150 SUB
41	182.37	150 SUB
42	109.70	150 SUB
43	102	150 SUB
44	170.95	150 SUB
45	170.95	150 SUB
46	170.95	150 SUB
47	170.95	150 SUB
108	108	108
109	109	109