


21453

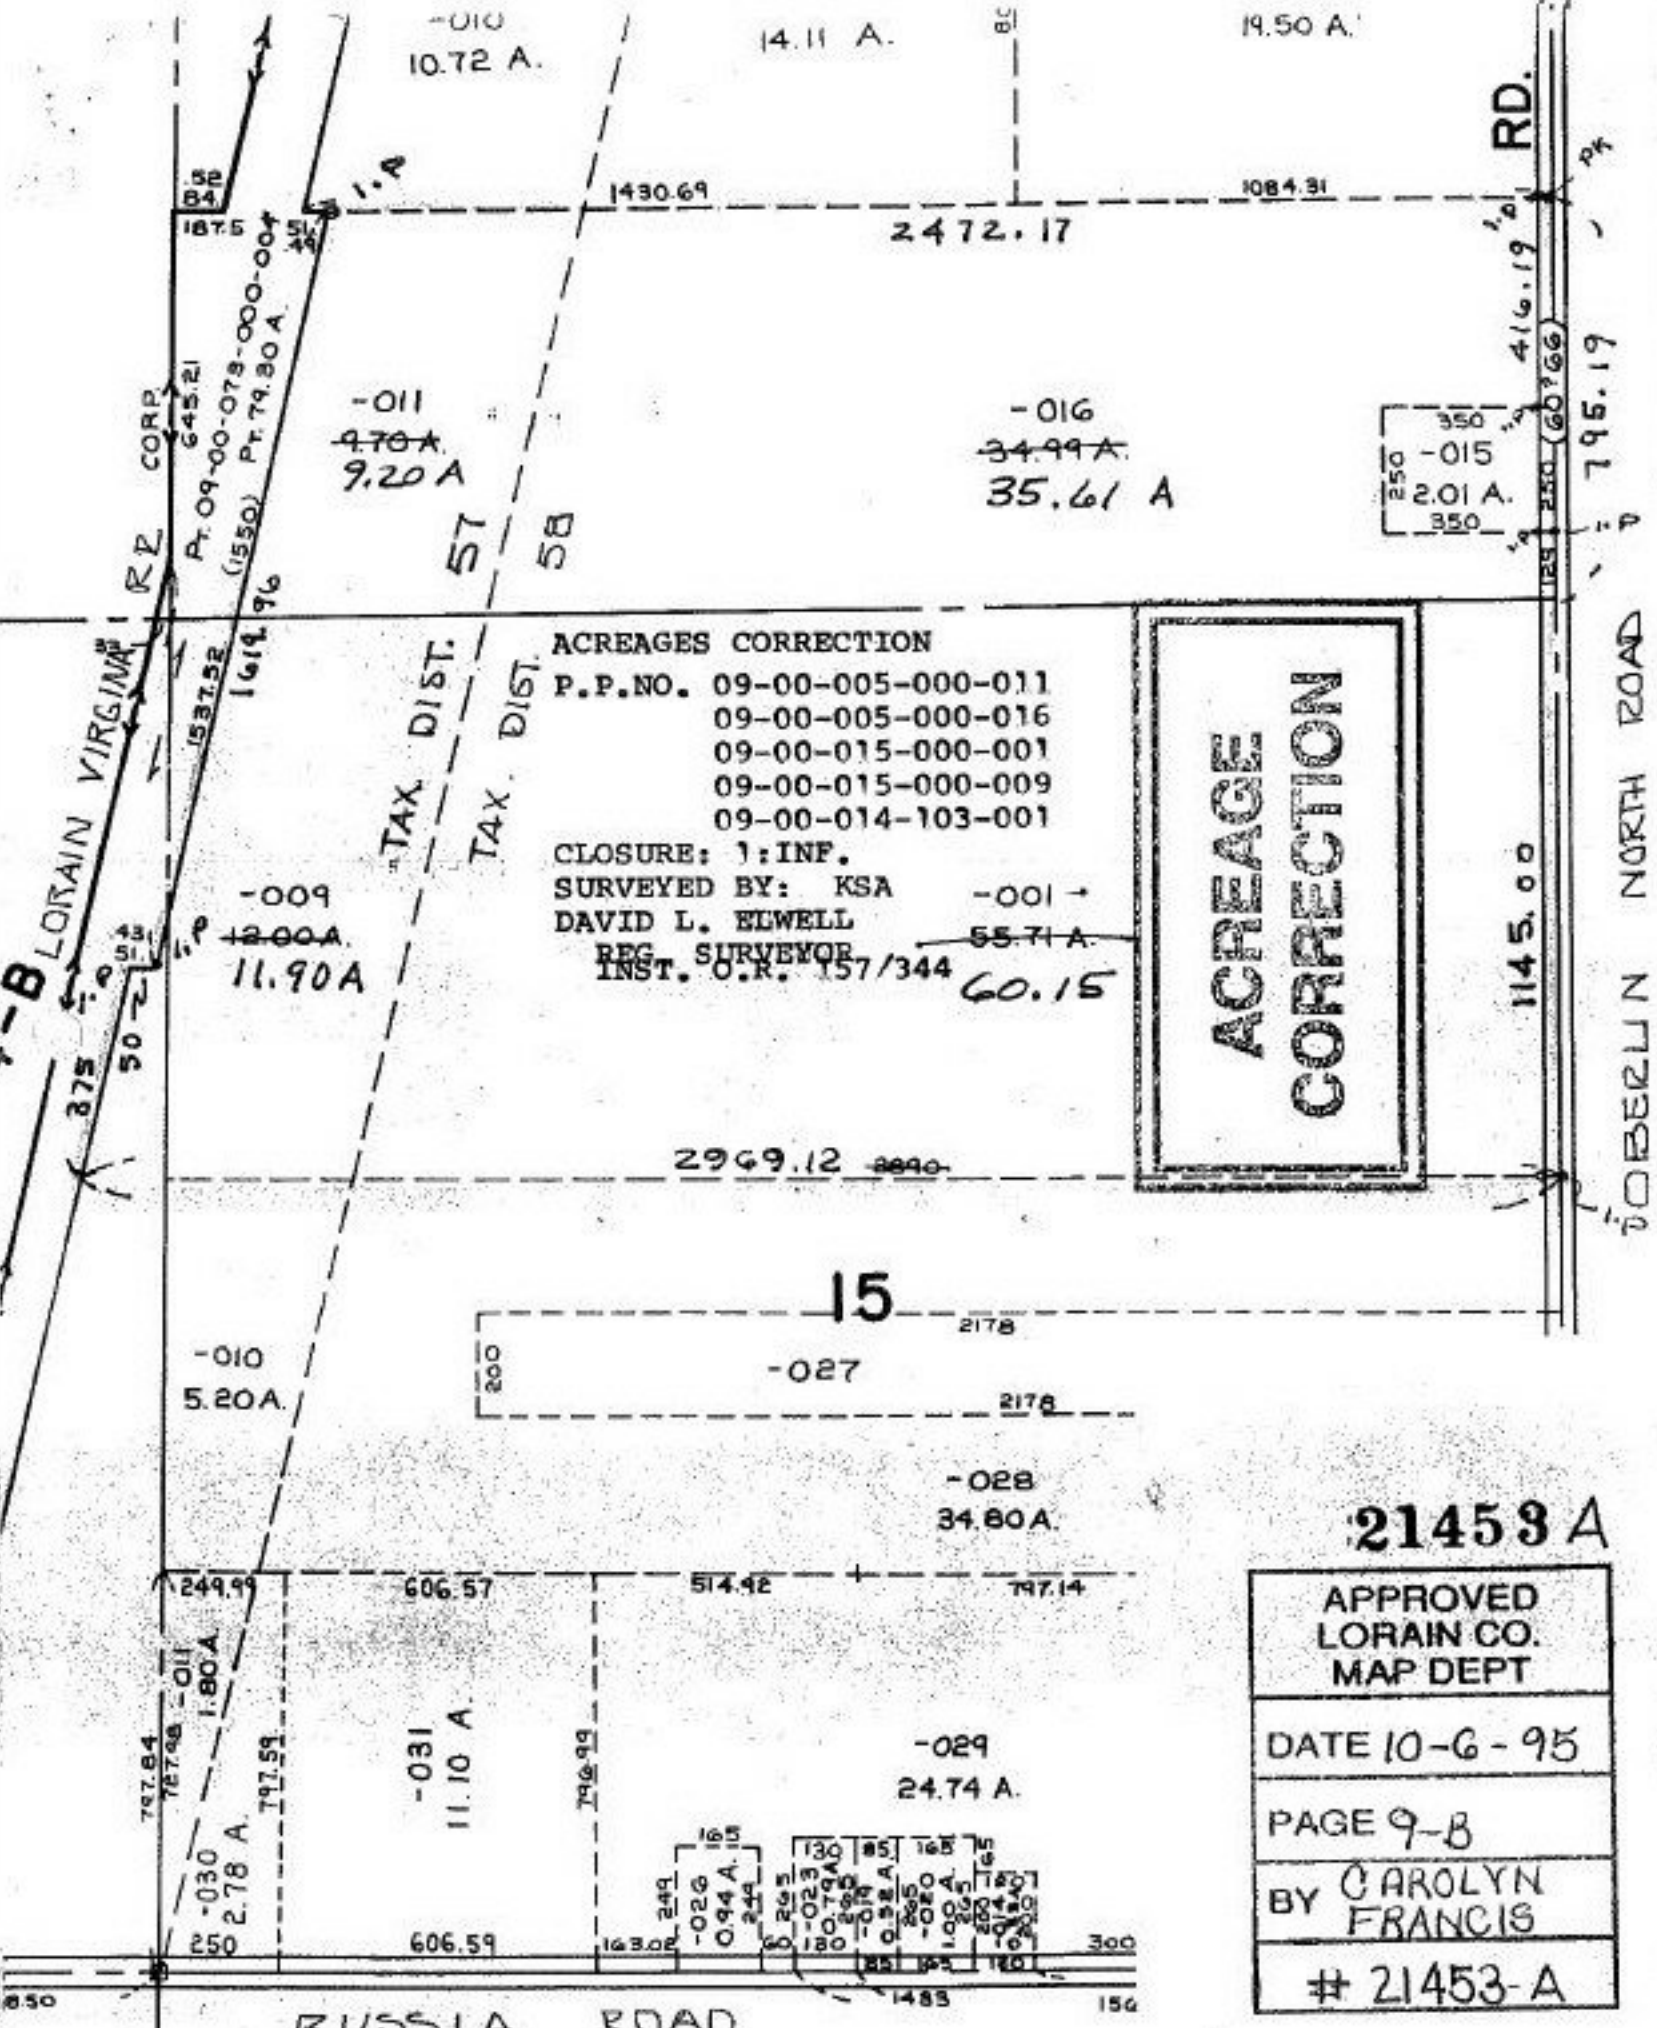

-011
4.70 A
9.20 A

14.11 A.

19.50 A.

1430.69

2472.17

1084.31

RD.

R.P. CORP.

Pt. 09-00-078-000-004
(1550) Pt. 79.80 A
1619.96

57

58

350
-015
2.01 A.
350

795.19

ACREAGES CORRECTION

- P.P.NO. 09-00-005-000-011
- 09-00-005-000-016
- 09-00-015-000-001
- 09-00-015-000-009
- 09-00-014-103-001

CLOSURE: 1:INF.
SURVEYED BY: KSA
DAVID L. ELWELL
REG. SURVEYOR
INST. O.R. 157/344

-001 -
55.71 A.
60.15

ACREAGE
CORRECTION

1145.00

TOBERLIN NORTH ROAD

2969.12

15

2178

-027

2178

-028
34.80 A.

-010
5.20 A.

21453 A

APPROVED
LORAIN CO.
MAP DEPT

DATE 10-6-95

PAGE 9-B

BY CAROLYN
FRANCIS

21453-A

RUSSIA ROAD

850

1483

156