


21453

TAYLOR ST.

SEE 6-108

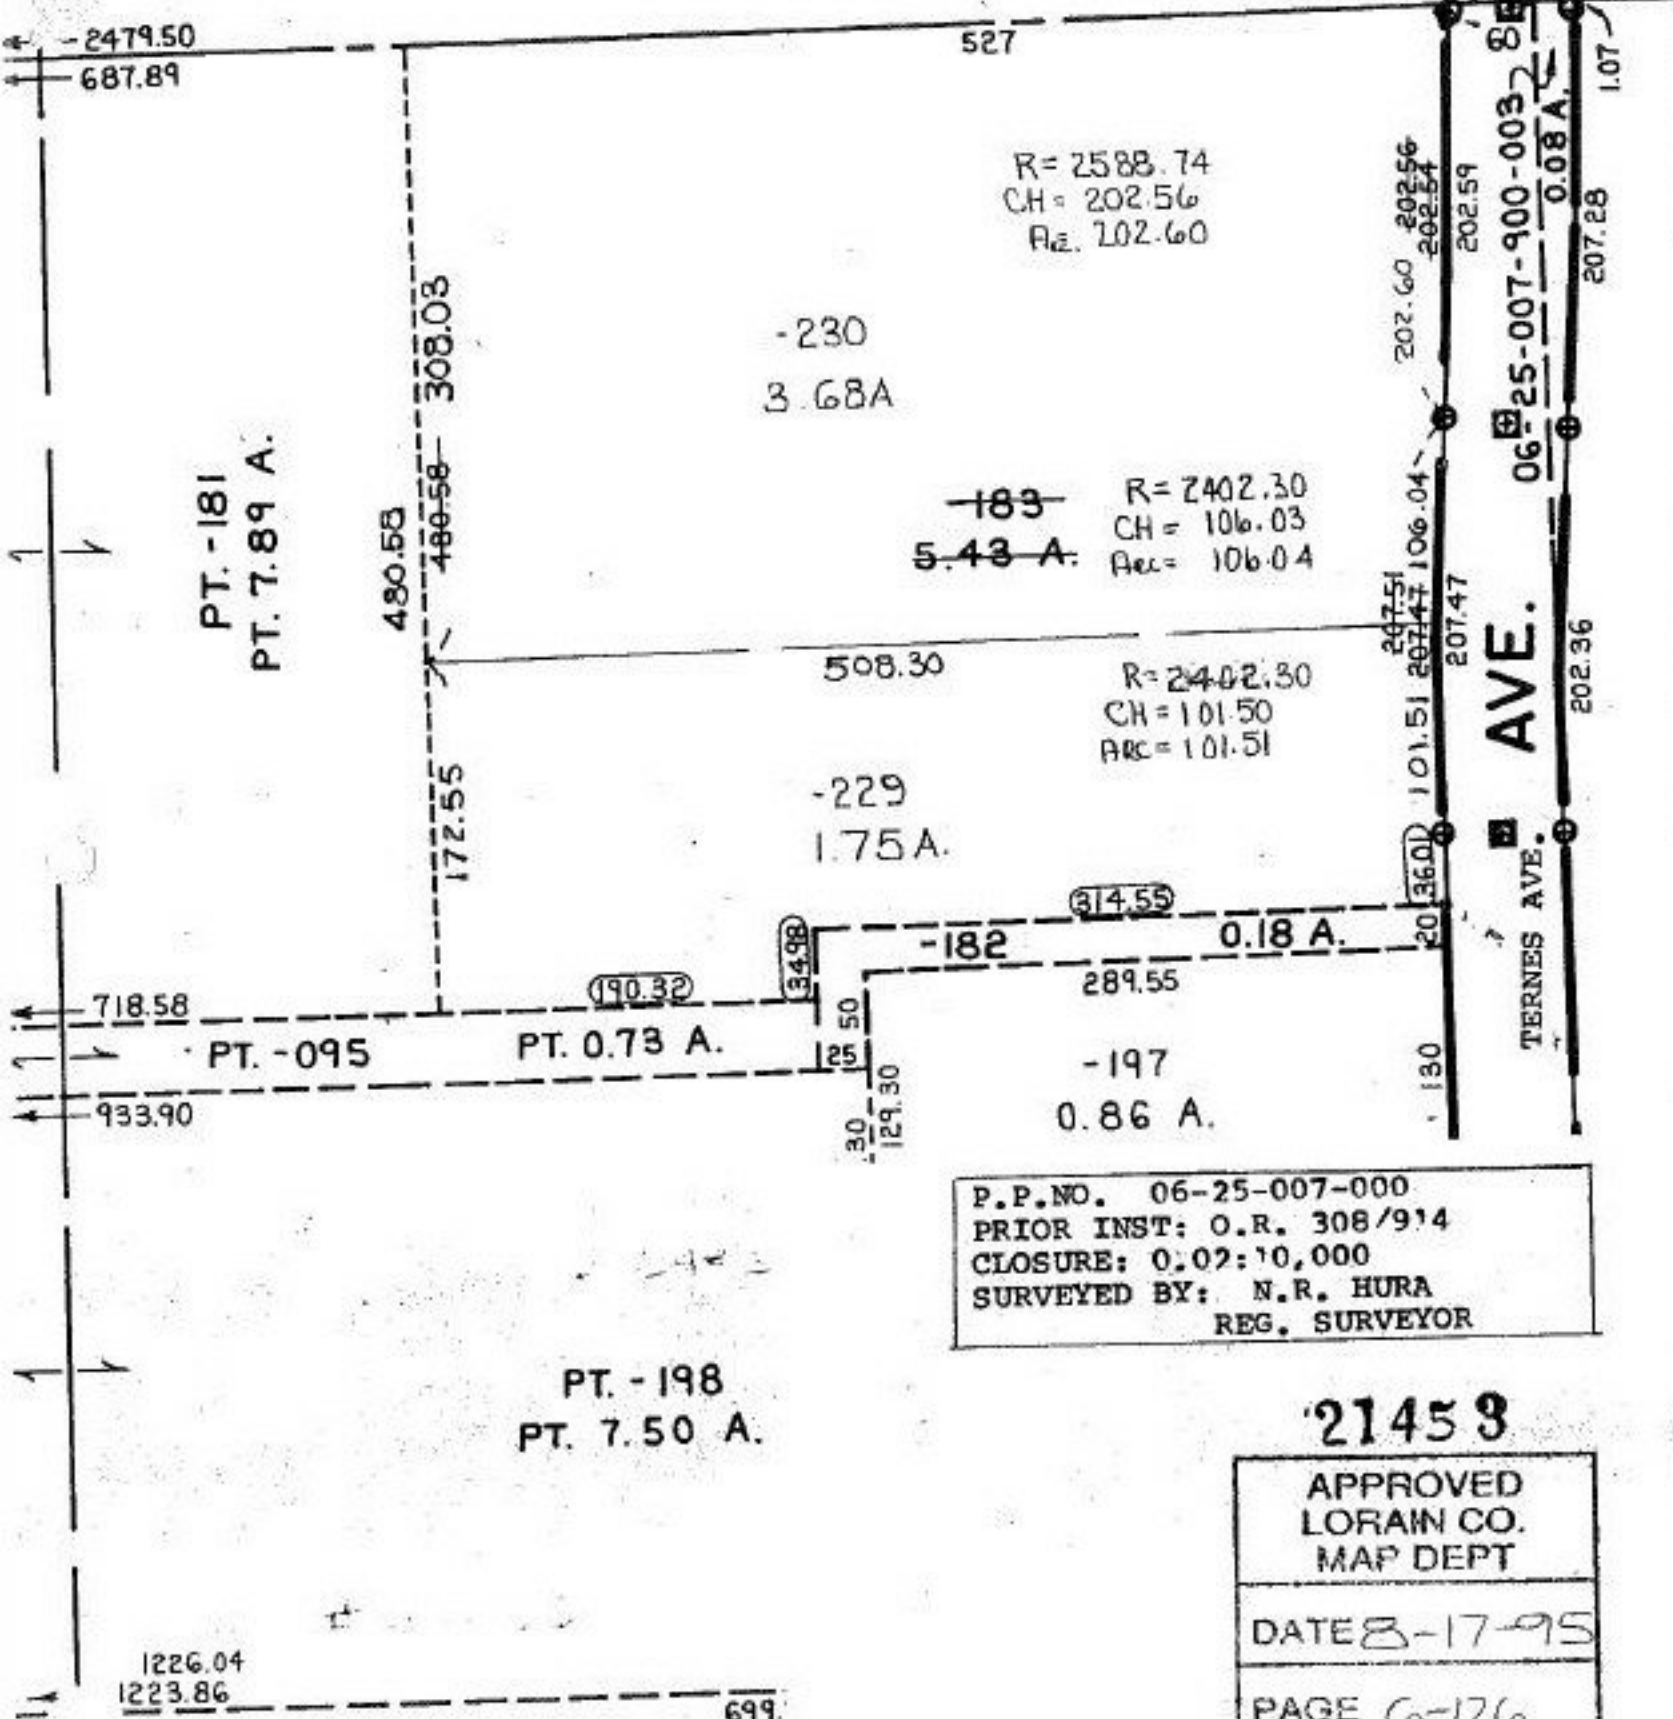

P.P.NO. 06-25-007-000
 PRIOR INST: O.R. 308/914
 CLOSURE: 0.02:10,000
 SURVEYED BY: N.R. HURA
 REG. SURVEYOR

21453

APPROVED
 LORAIN CO.
 MAP DEPT

DATE 8-17-95

PAGE 6-126

BY CAROLYN
 FRANCIS

21453