



#21464-D

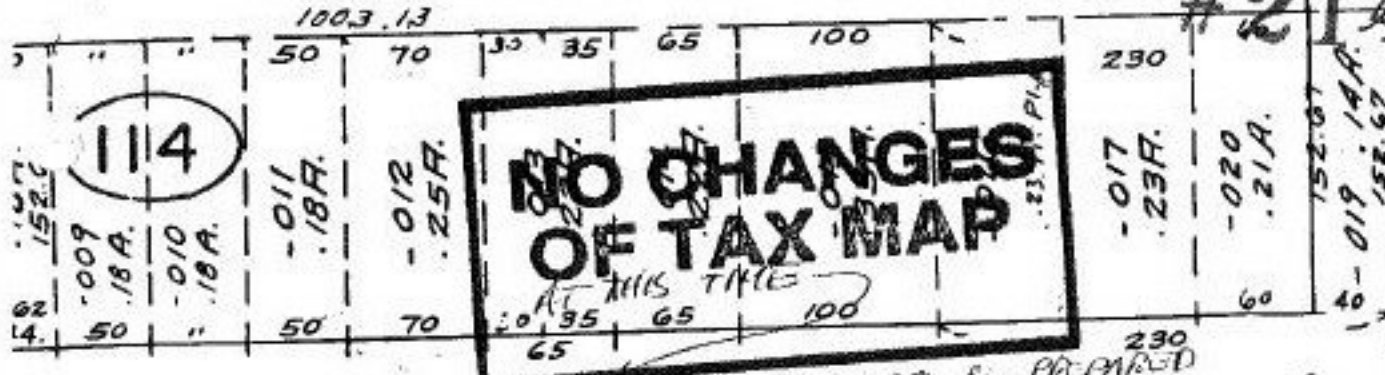


DEED CHECK

HILLIARD RD. NEW DEEDS TO BE PREPARED TO CORRECTLY DESCRIBE EXCEPTED AREAS. 370.05

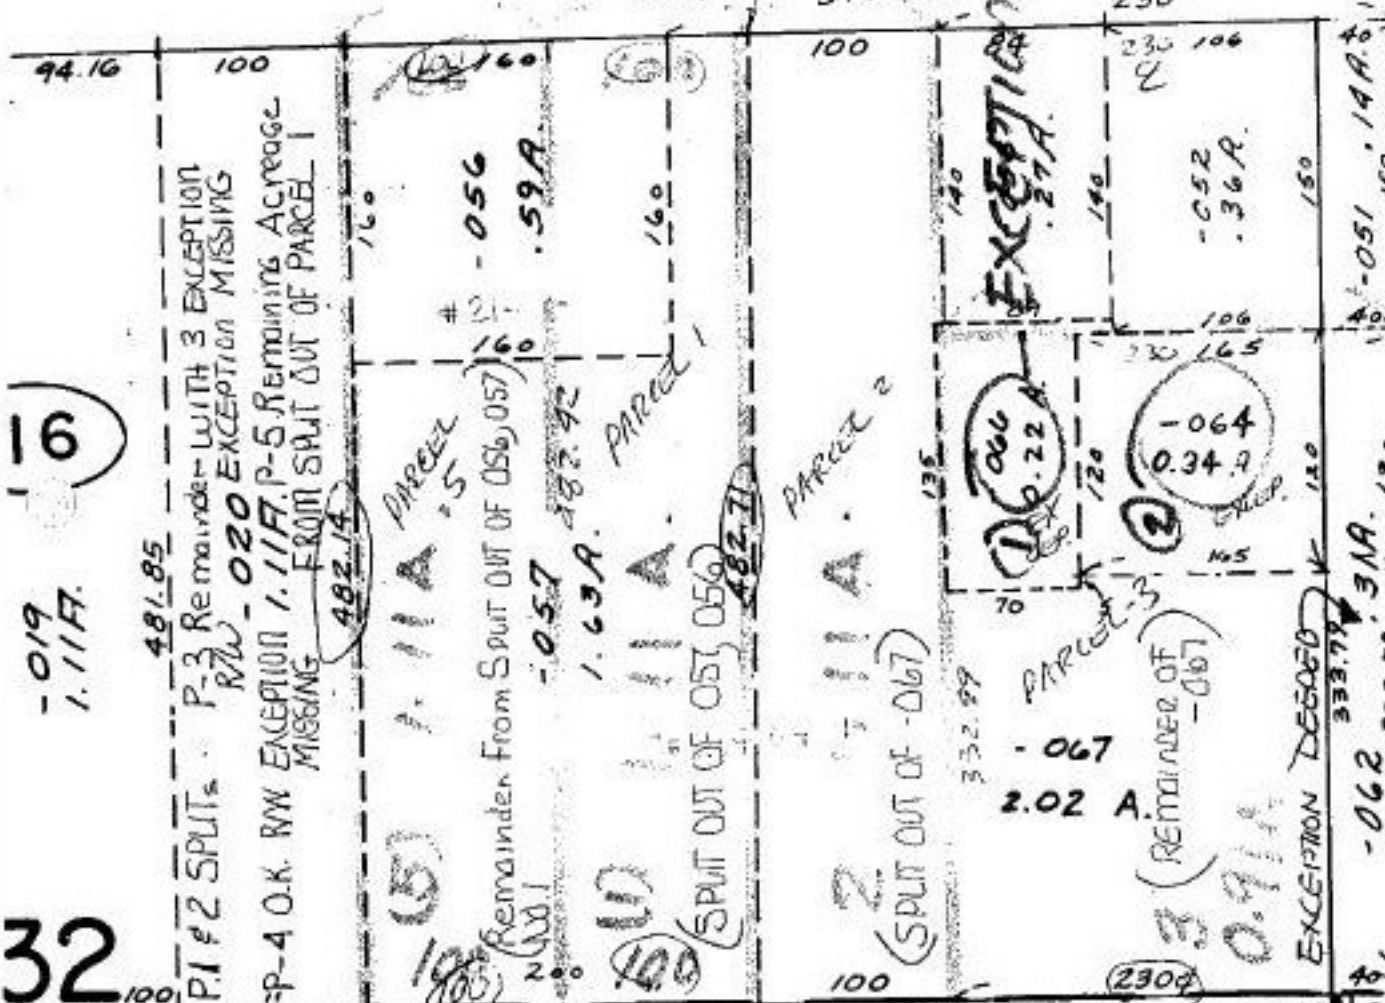

SEE 6-71

EXCEPTION NEEDED POSSIBLE DV. 1022/117

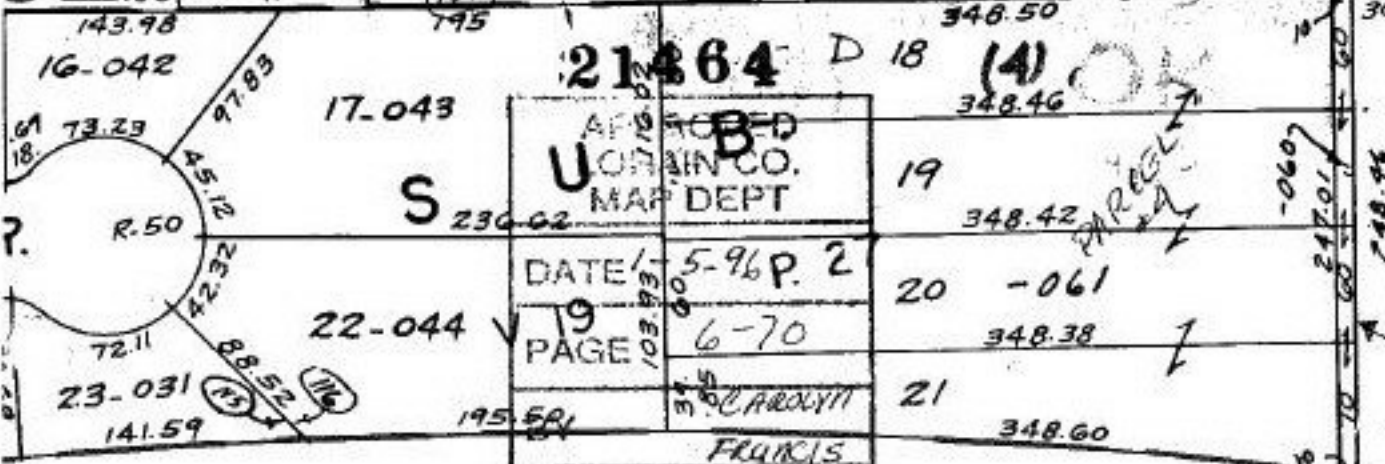

21464 D 18	
APPROVED	UNRECORDED
COUNTY MAP DEPT	
DATE	5-96 P. 2
PAGE	6-70
FRANCIS	
#21464-D	