


21472

SPRAGUE ROAD

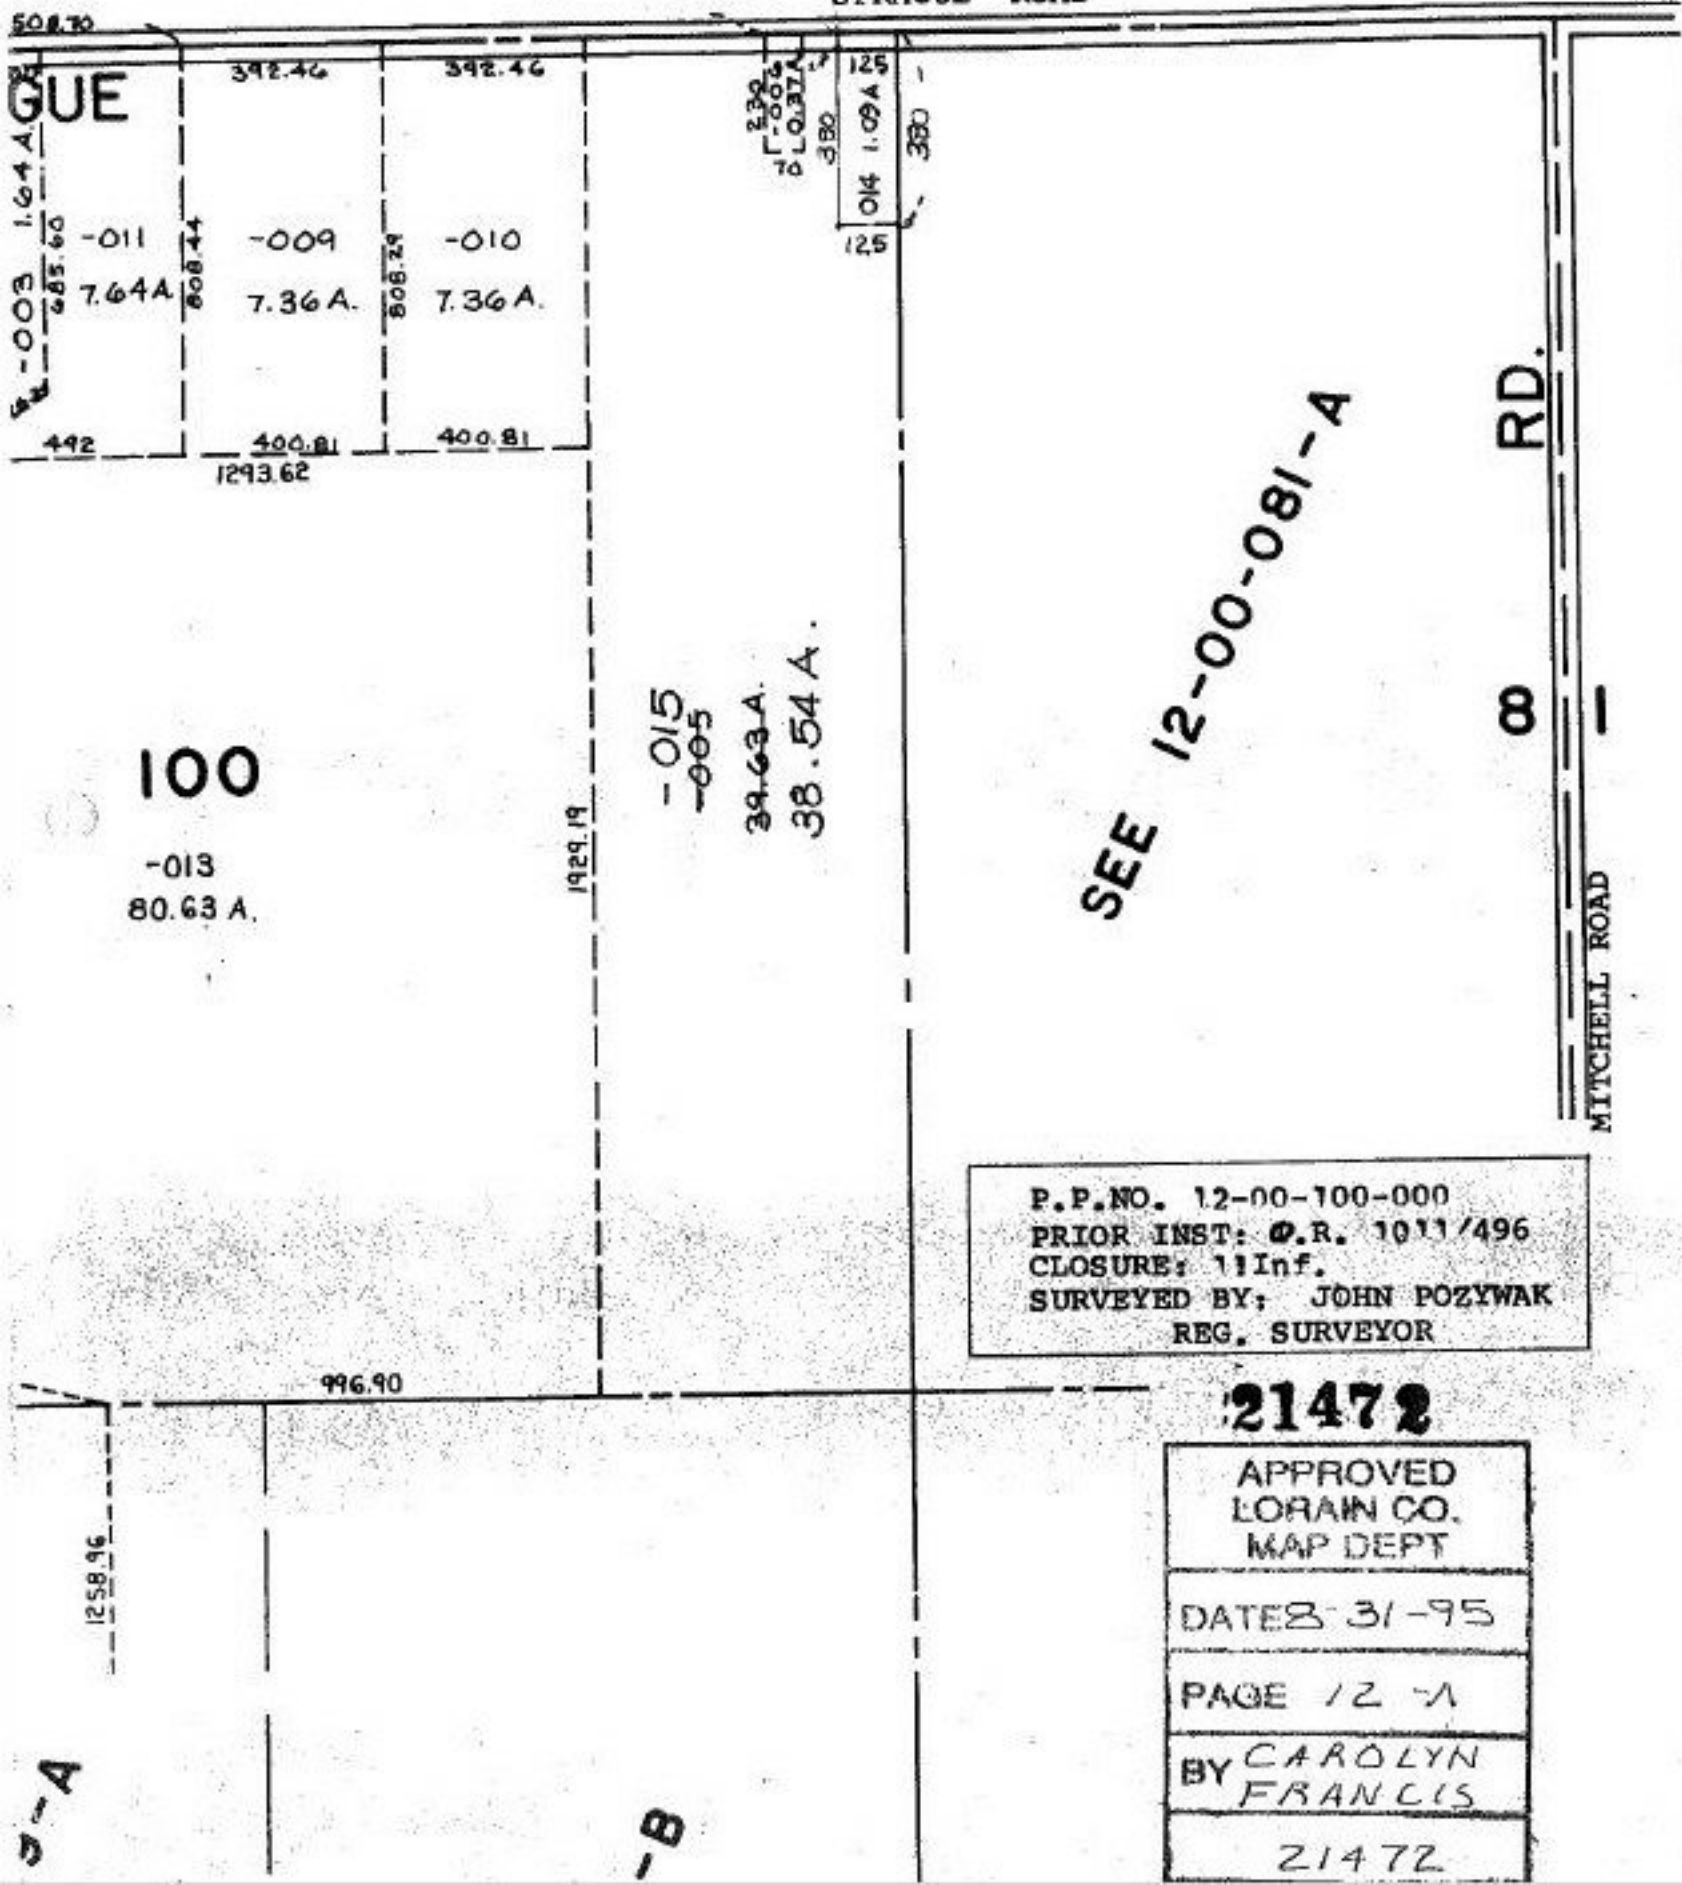

508.70	392.46	392.46
1.64 A	-011	-009
685.60	7.64 A	7.36 A
492	400.81	400.81
	1293.62	

230
 17-006
 6 LQ.37A
 380
 125
 014 1.09 A

100

-013
80.63 A.

1929.19

-015
-005

39.63 A.
38.54 A.

SEE 12-00-081-A

RD.
8

MITCHELL ROAD

P.P.NO. 12-00-100-000
 PRIOR INST: O.R. 1011/496
 CLOSURE: 11 Inf.
 SURVEYED BY: JOHN POZYWAK
 REG. SURVEYOR

21472

APPROVED
LORAIN CO.
MAP DEPT

DATE 8-31-95

PAGE 12 -A

BY CAROLYN
FRANCIS

21472

1258.96

3-A

-B