

21473A

05-00-006-000-056


~~28.19 A.~~

30.26 A.

Sec OP 1155/314

FILED 10/21/95

SEE SURVEY MAP & DES. BY VINCENT HIGGINS
CL. 1:5,000,000
PRIME INSTR. REF. - DV 1372/825

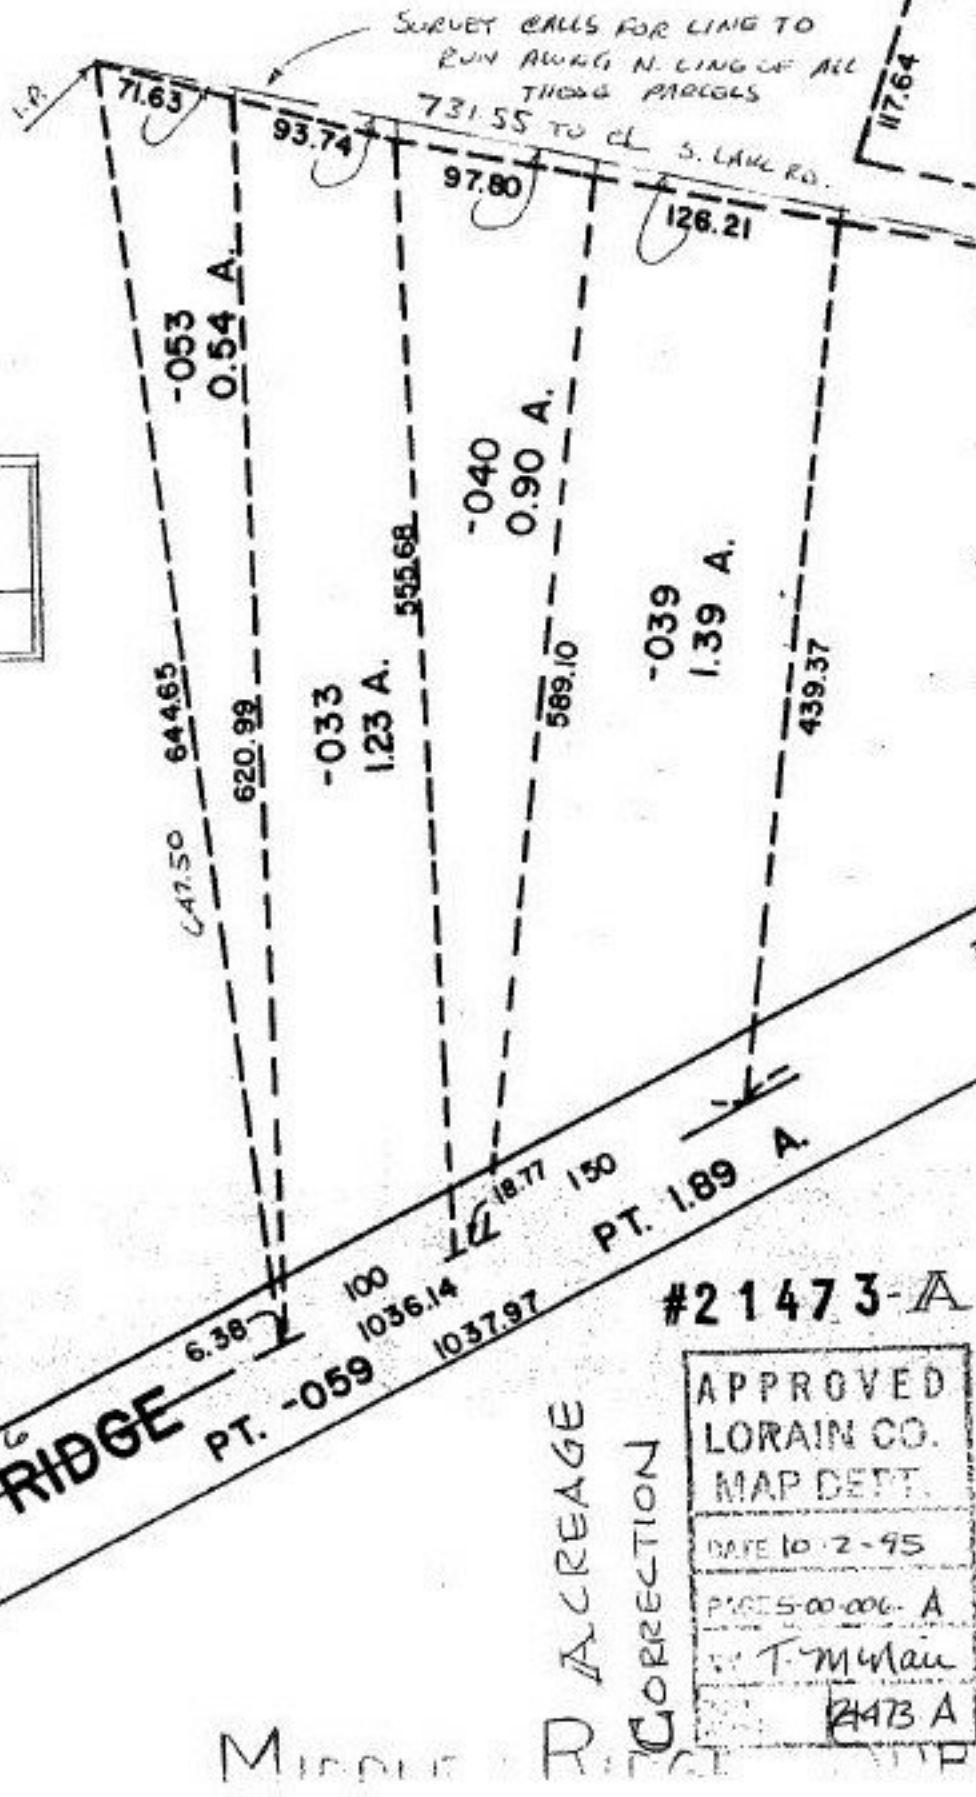

#21473-A

MIDDLE RIDGE

ACREAGE CORRECTION

APPROVED
LORAIN CO.
MAP DEPT.
DATE 10-2-95
PAGE 5-00-006-A
T. M. Man
2473 A