


1580.88 → TO CL 5. LANE PD

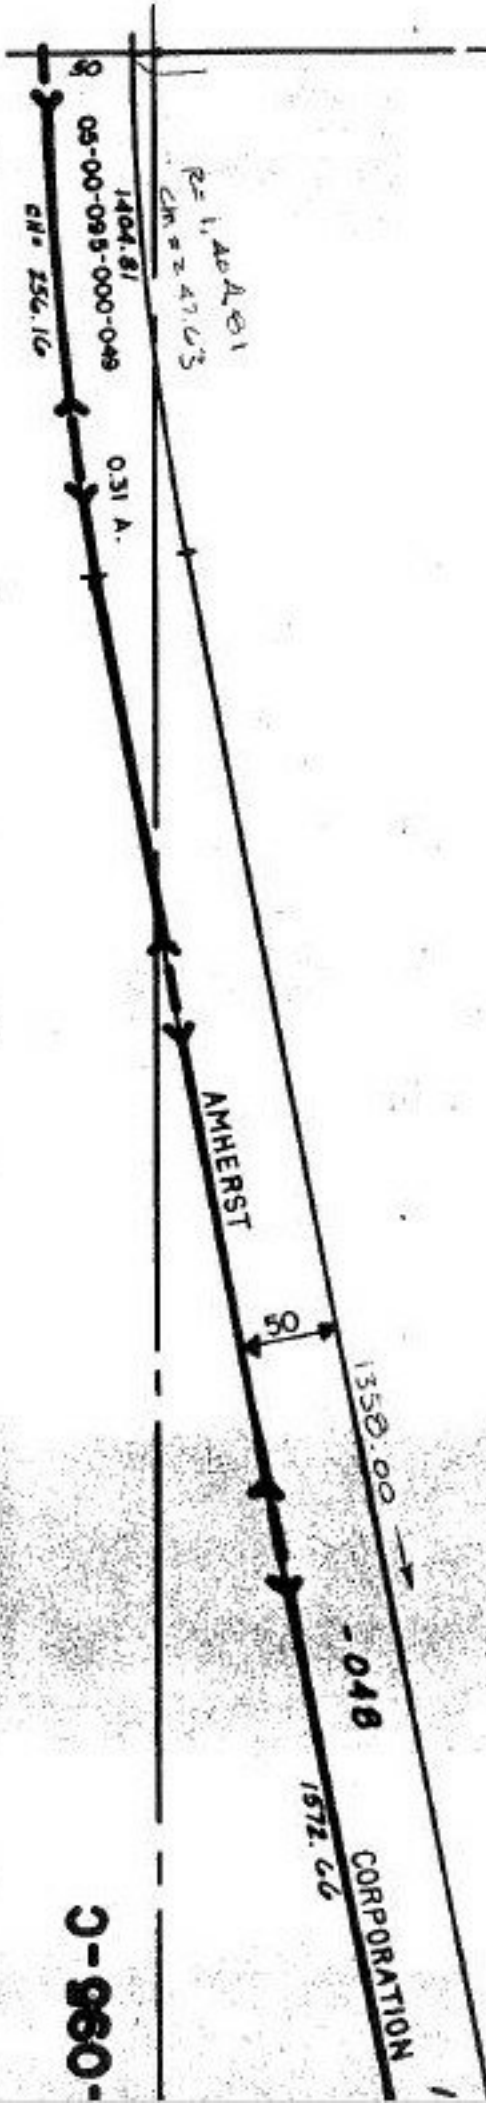

SEE SURVEY MAP & DISC. BY
VINCENT HIGHERWAY
CL. 1:5,000,000
PRICE INST. POP. - DV 1372/825

FILED 10/2/95

05-00-006-000-

-056

OR 1155/314

30.26 A. 28.19

2147

#21473-A

ACREAGE
CORRECTION

APPROVED LORAIN CO. MAP DEPT.	
DATE 10-2-95	
PAGE 5-00-006-A	
BY T. J. Hain	
VOID AFTER	21473-A

71.63 93.74