


SEE 7-00-025-B

WOOSTER AVON LAKE

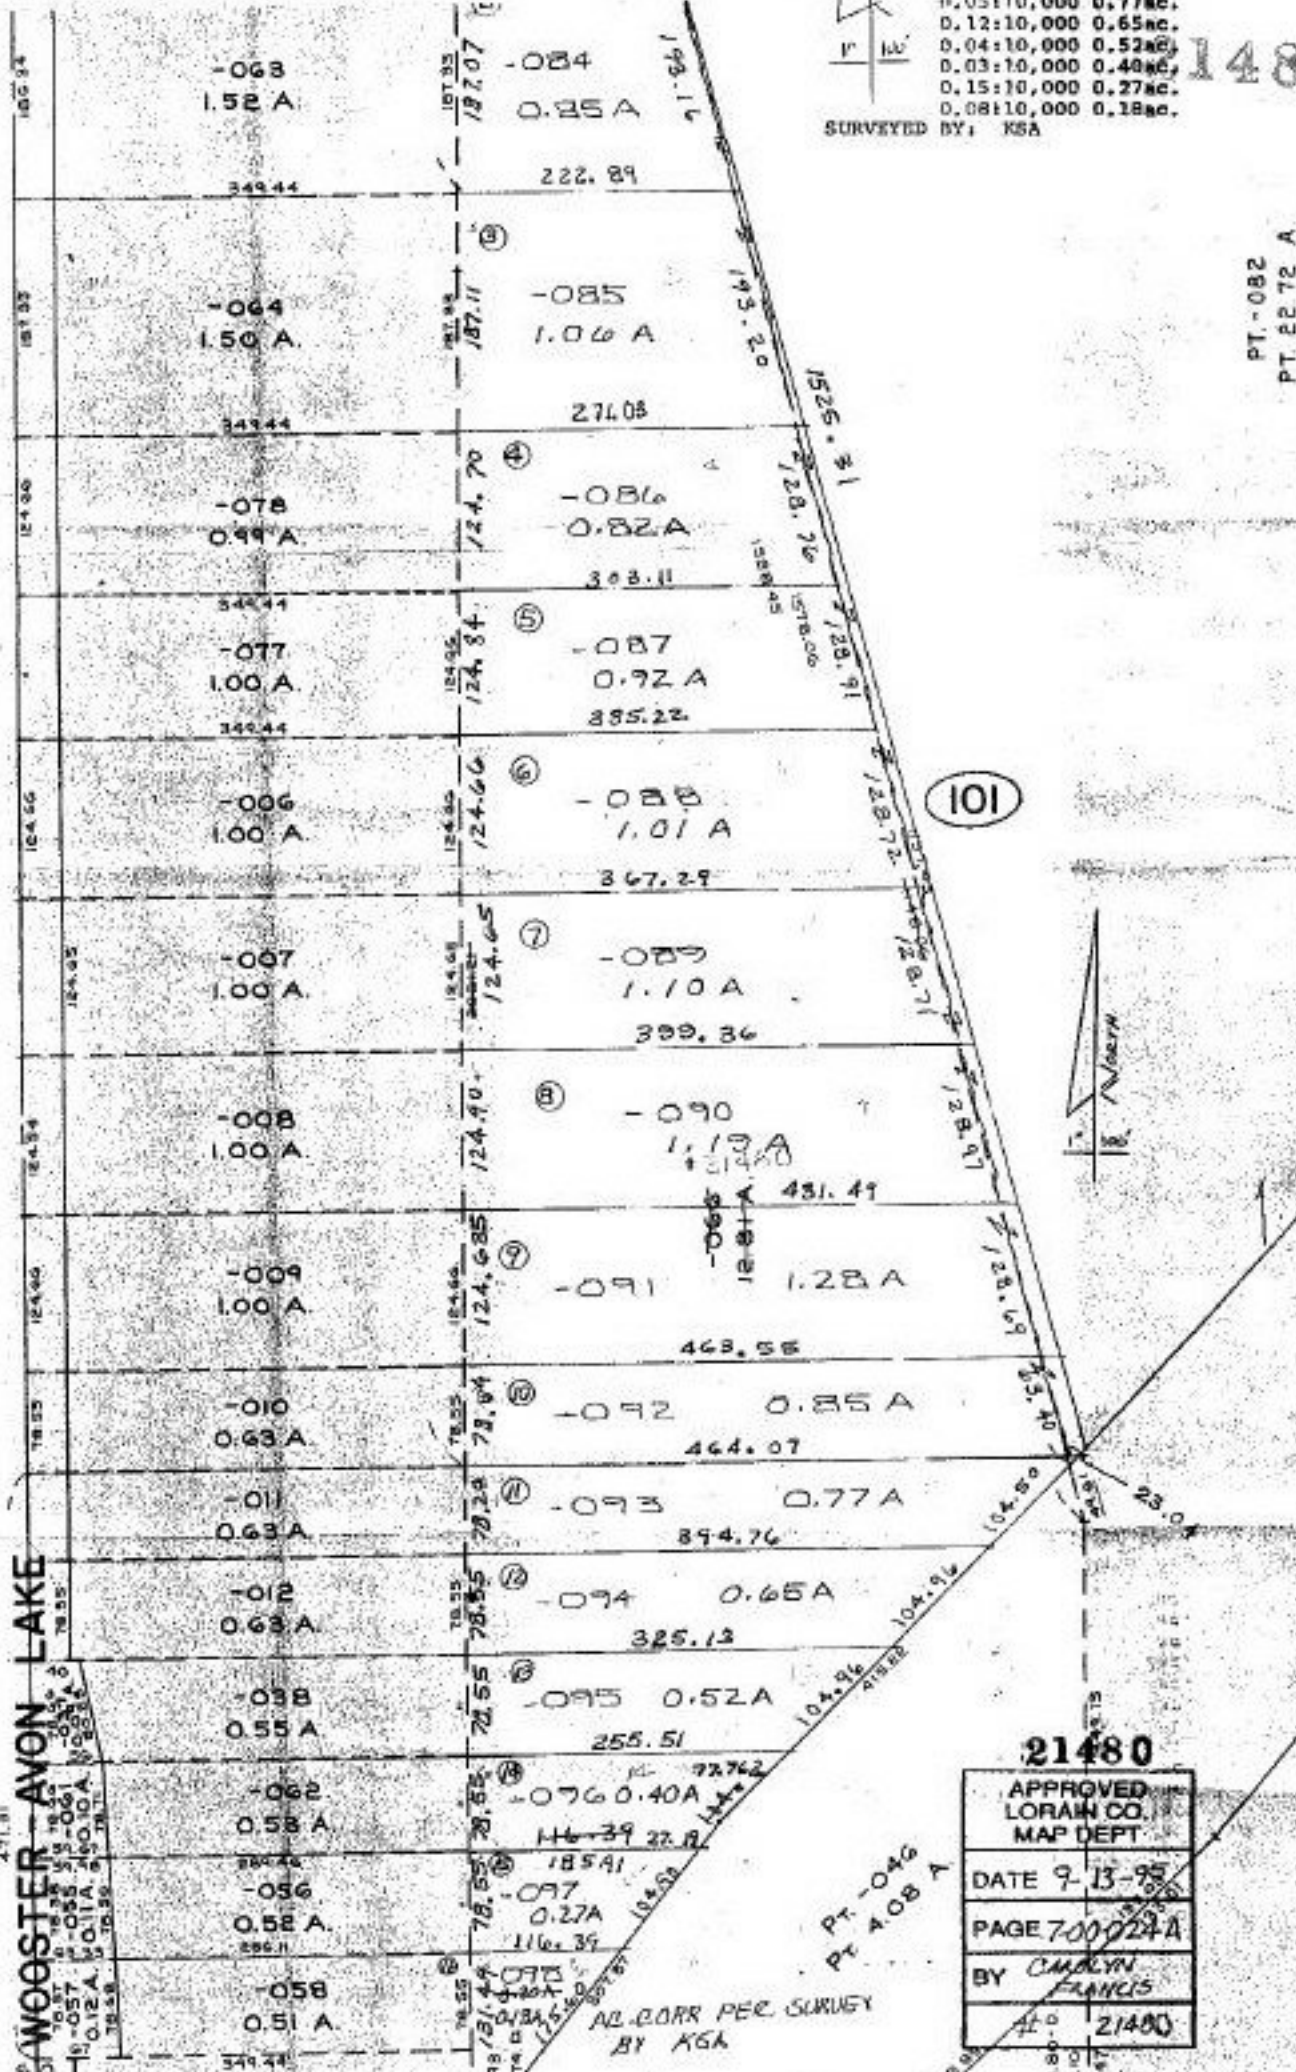

0.05:10,000 0.77ac.  
 0.12:10,000 0.65ac.  
 0.04:10,000 0.52ac.  
 0.03:10,000 0.40ac.  
 0.15:10,000 0.27ac.  
 0.08:10,000 0.28ac.

SURVEYED BY: KSA

1480

PT. -082  
PT. 22 72 A

101

21480

APPROVED  
LORAIN CO.  
MAP DEPT

DATE 9-13-95

PAGE 700-025-A

BY CARMELYN FRANCIS

# 21480

PT. -046  
PT. A.08 A

ALL CORR PER SURVEY  
BY KSA

83