


#21490-D

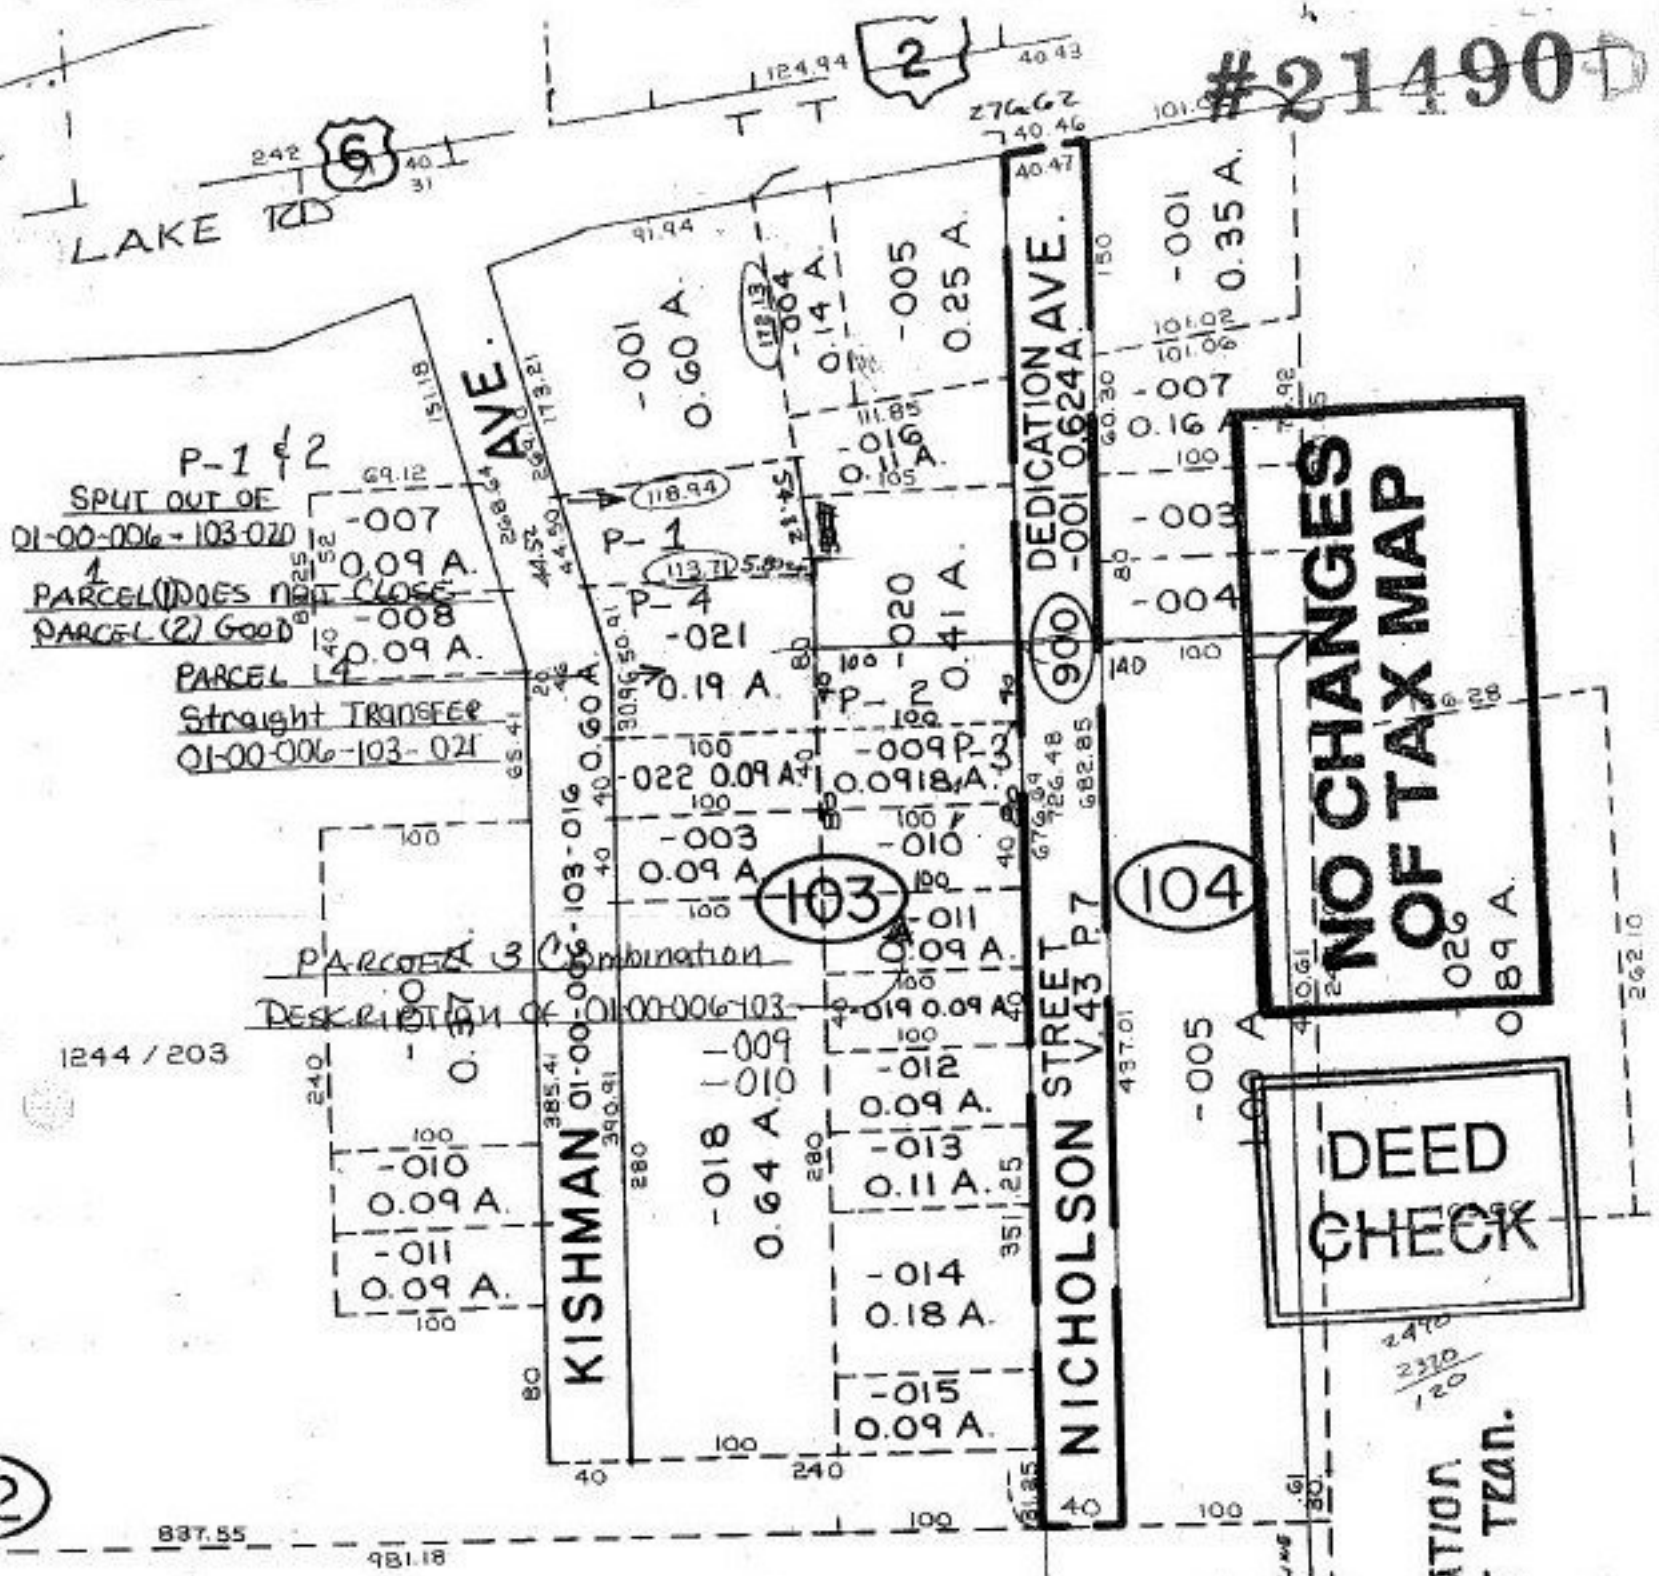

**NO CHANGES
OF TAX MAP**

**DEED
CHECK**

2490
2370
120

PROPOSE SPLITS
COMBINATION
STRAIGHT TRAN.

PARCEL 1 SPLIT OUT OF -020 DOES NOT CLOSE
2 11 11 11 11
2-NEED SURVEYED AND SURVEYORS NAME
NEED AC. ON DEED
PARCEL 3 COMBINATION -009, 010
-005
9.26 A
PARCEL 4 STRAIGHT TRANSFER
GOOD

APPROVED
LORAIN CO.
MAP DEPT
DATE 3-7-96
PAGE 1-00-006A
BY CAROLYN
FRANCS

21490-D