


#21499

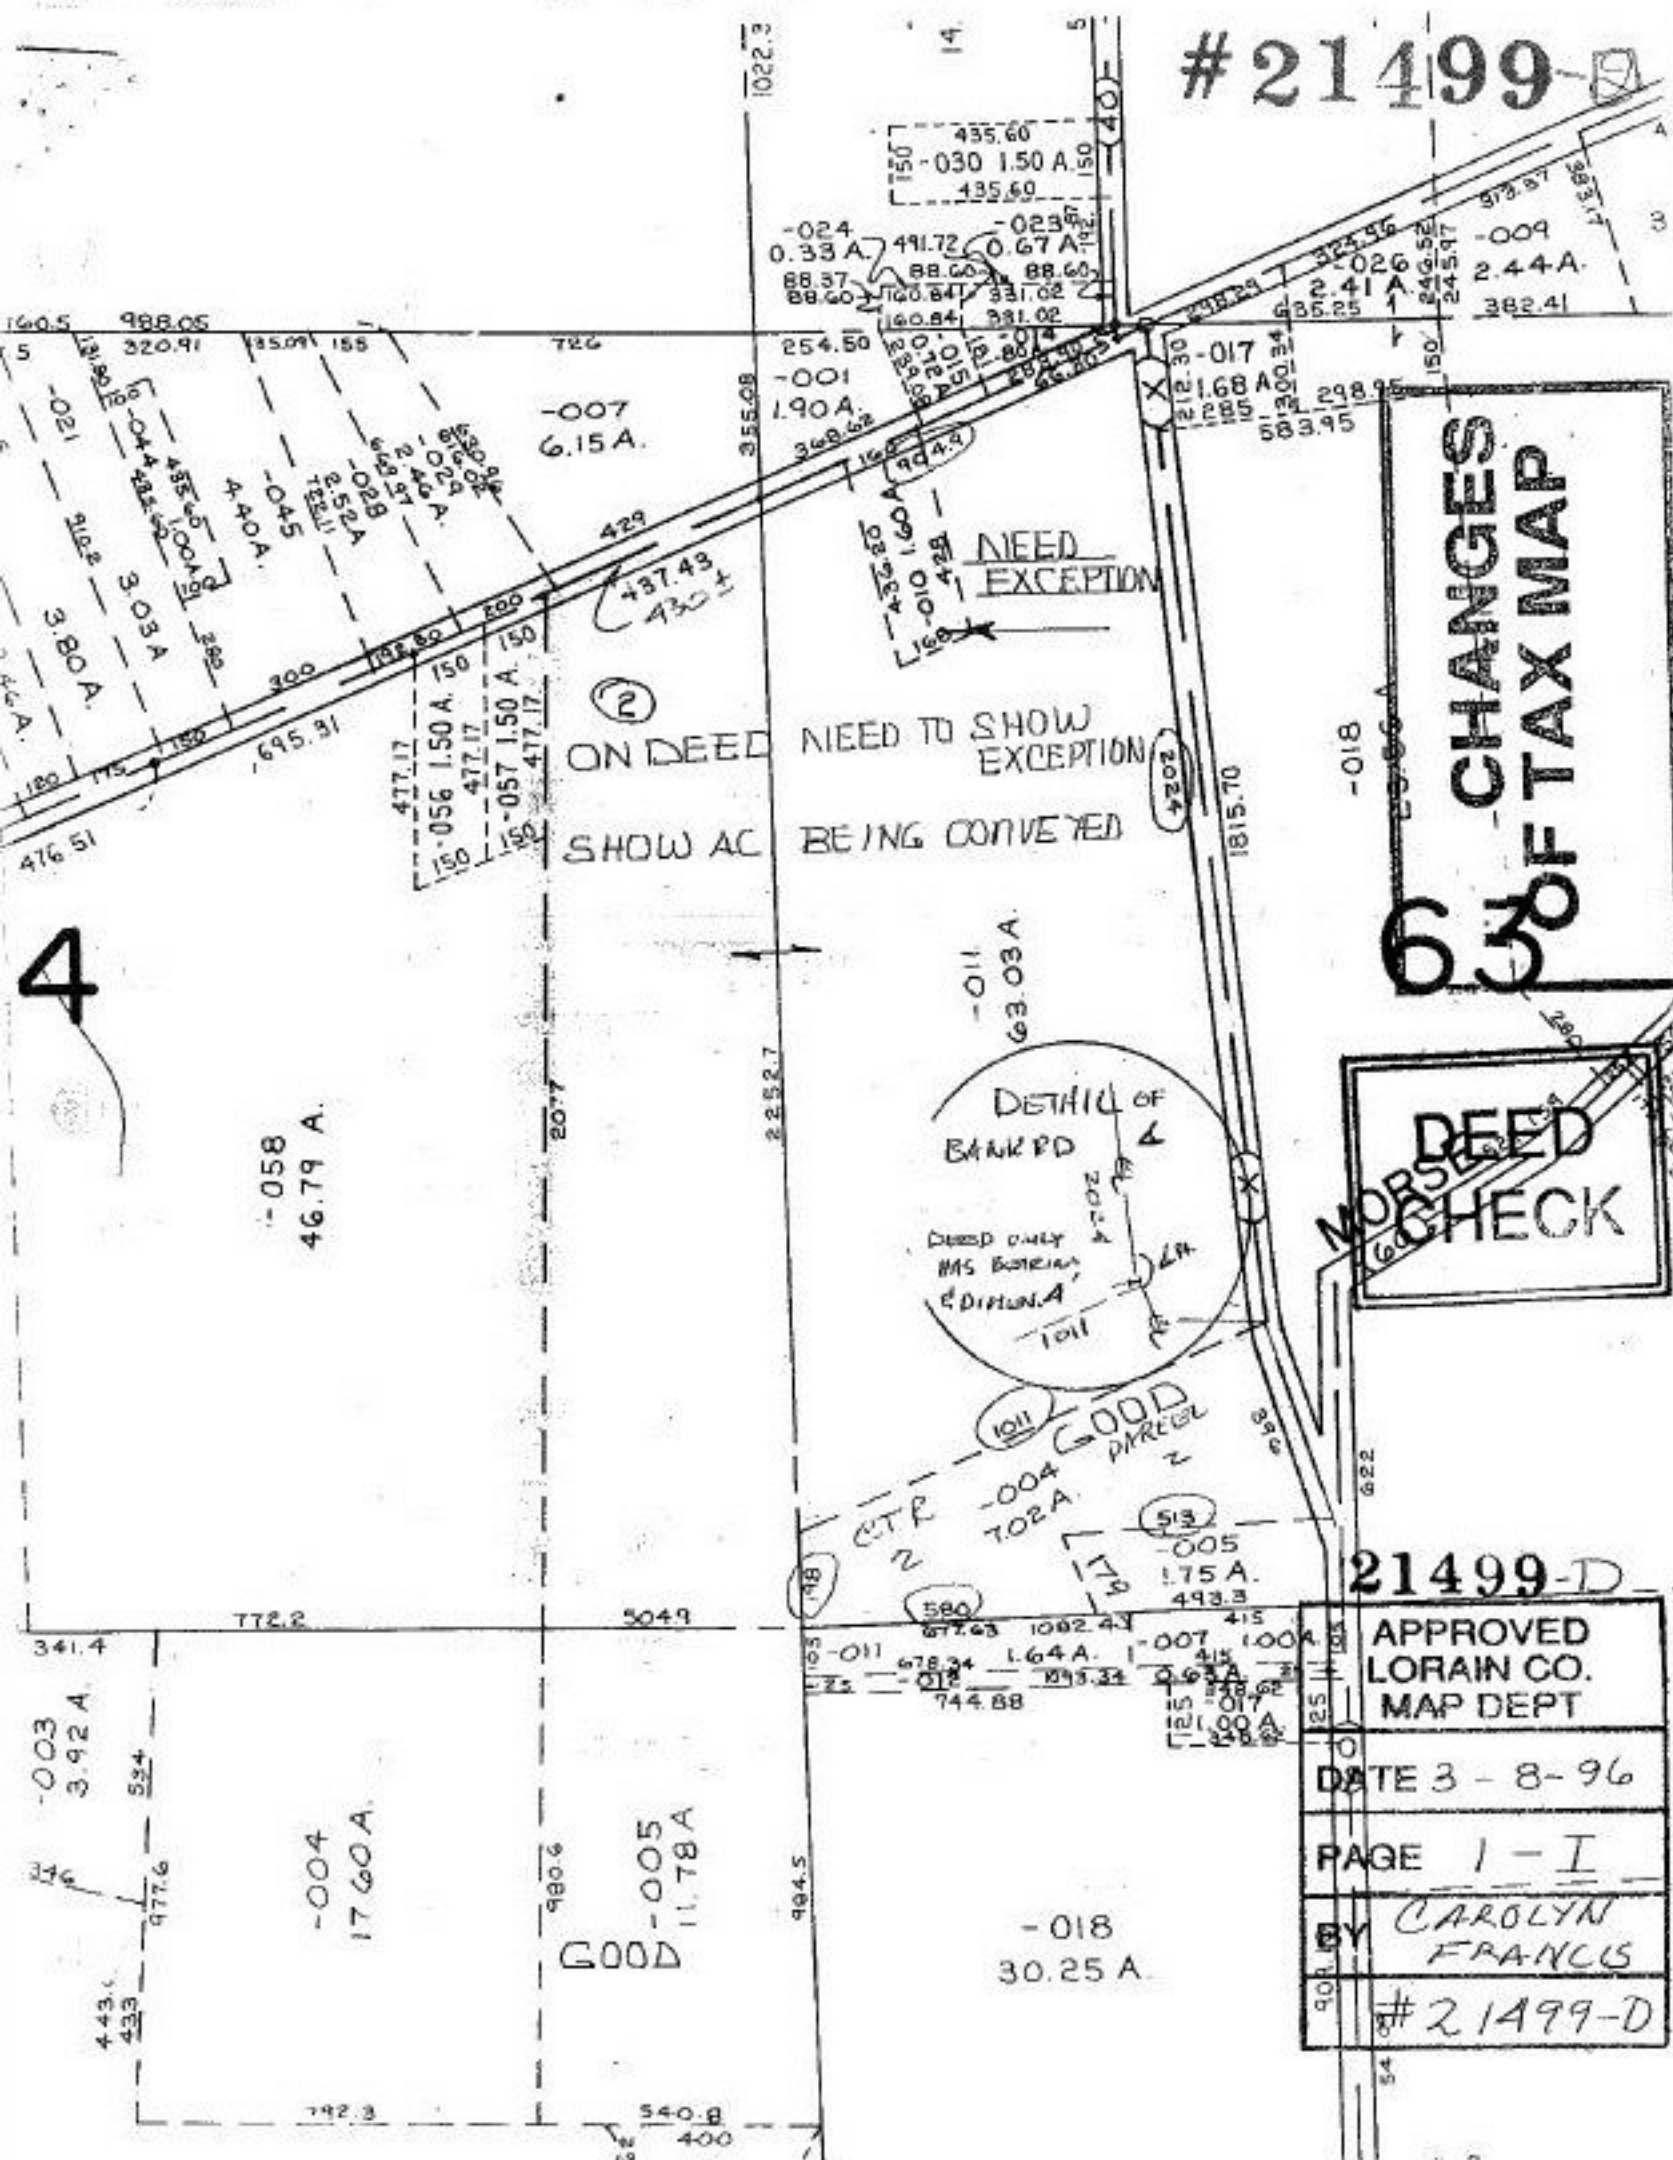

ON DEED NEED TO SHOW EXCEPTION  
SHOW AC BEING CONVEYED

NEED EXCEPTION

DETAIL OF BANKRD  
DEED ONLY HAS BUREAU EDITION A  
1011

63% CHANGES OF TAX MAP

DEED CHECK

21499-D  
APPROVED LORAIN CO. MAP DEPT  
DATE 3-8-96  
PAGE 1-I  
BY CAROLYN FRANCIS  
#21499-D

4

-058  
46.79 A.

-004  
17.60 A.

GOOD  
-005  
11.78 A.

-018  
30.25 A.

-018

-011  
63.03 A.

-007  
6.15 A.

1022.3

14

5

988.05  
320.91  
135.091 158

355.08

2252.7

772.2

5049

984.5

980.6

540.8  
400

150

150

