

SEE 1-J

-004  
17.60A

-005  
11.78A

DEED  
CHECK

NO CHANGES  
OF TAX MAP

-002  
20.00A

-003  
25.00A

21499-D

APPROVED  
LORAIN CO.  
MAP DEPT  
DATE 3-8-96  
PAGE 1-J  
BY CAROLYN  
FRANCIS  
# 21499-D

66

ETR  
COULD USE UPDATED  
INFORMATION


-004  
37.00A

-005  
28.19A

O.R. 833/727

ORRHANAGE  
RD

DEED DOES NOT  
SURVEYED

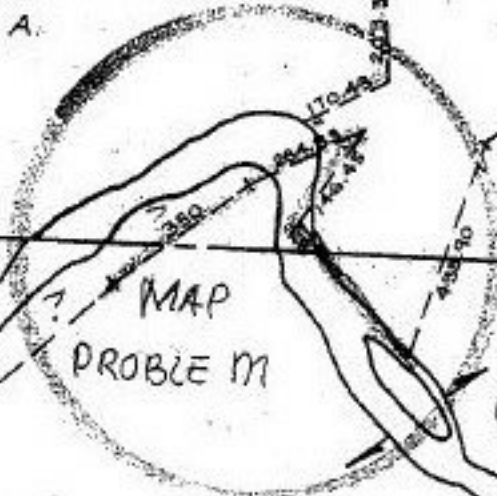

O.R. 969/348  
DISTANCES ON TAX  
MAP  
AGREE

# 21499-D

