

DETROIT RD.

LONG RD.

831.70

P.P. 8
REF. FOR AC. SURVEYS AT THIS TIME

+50 AC. COR. EL


DPB

SEE 4-00-002-H

LONG

60

60

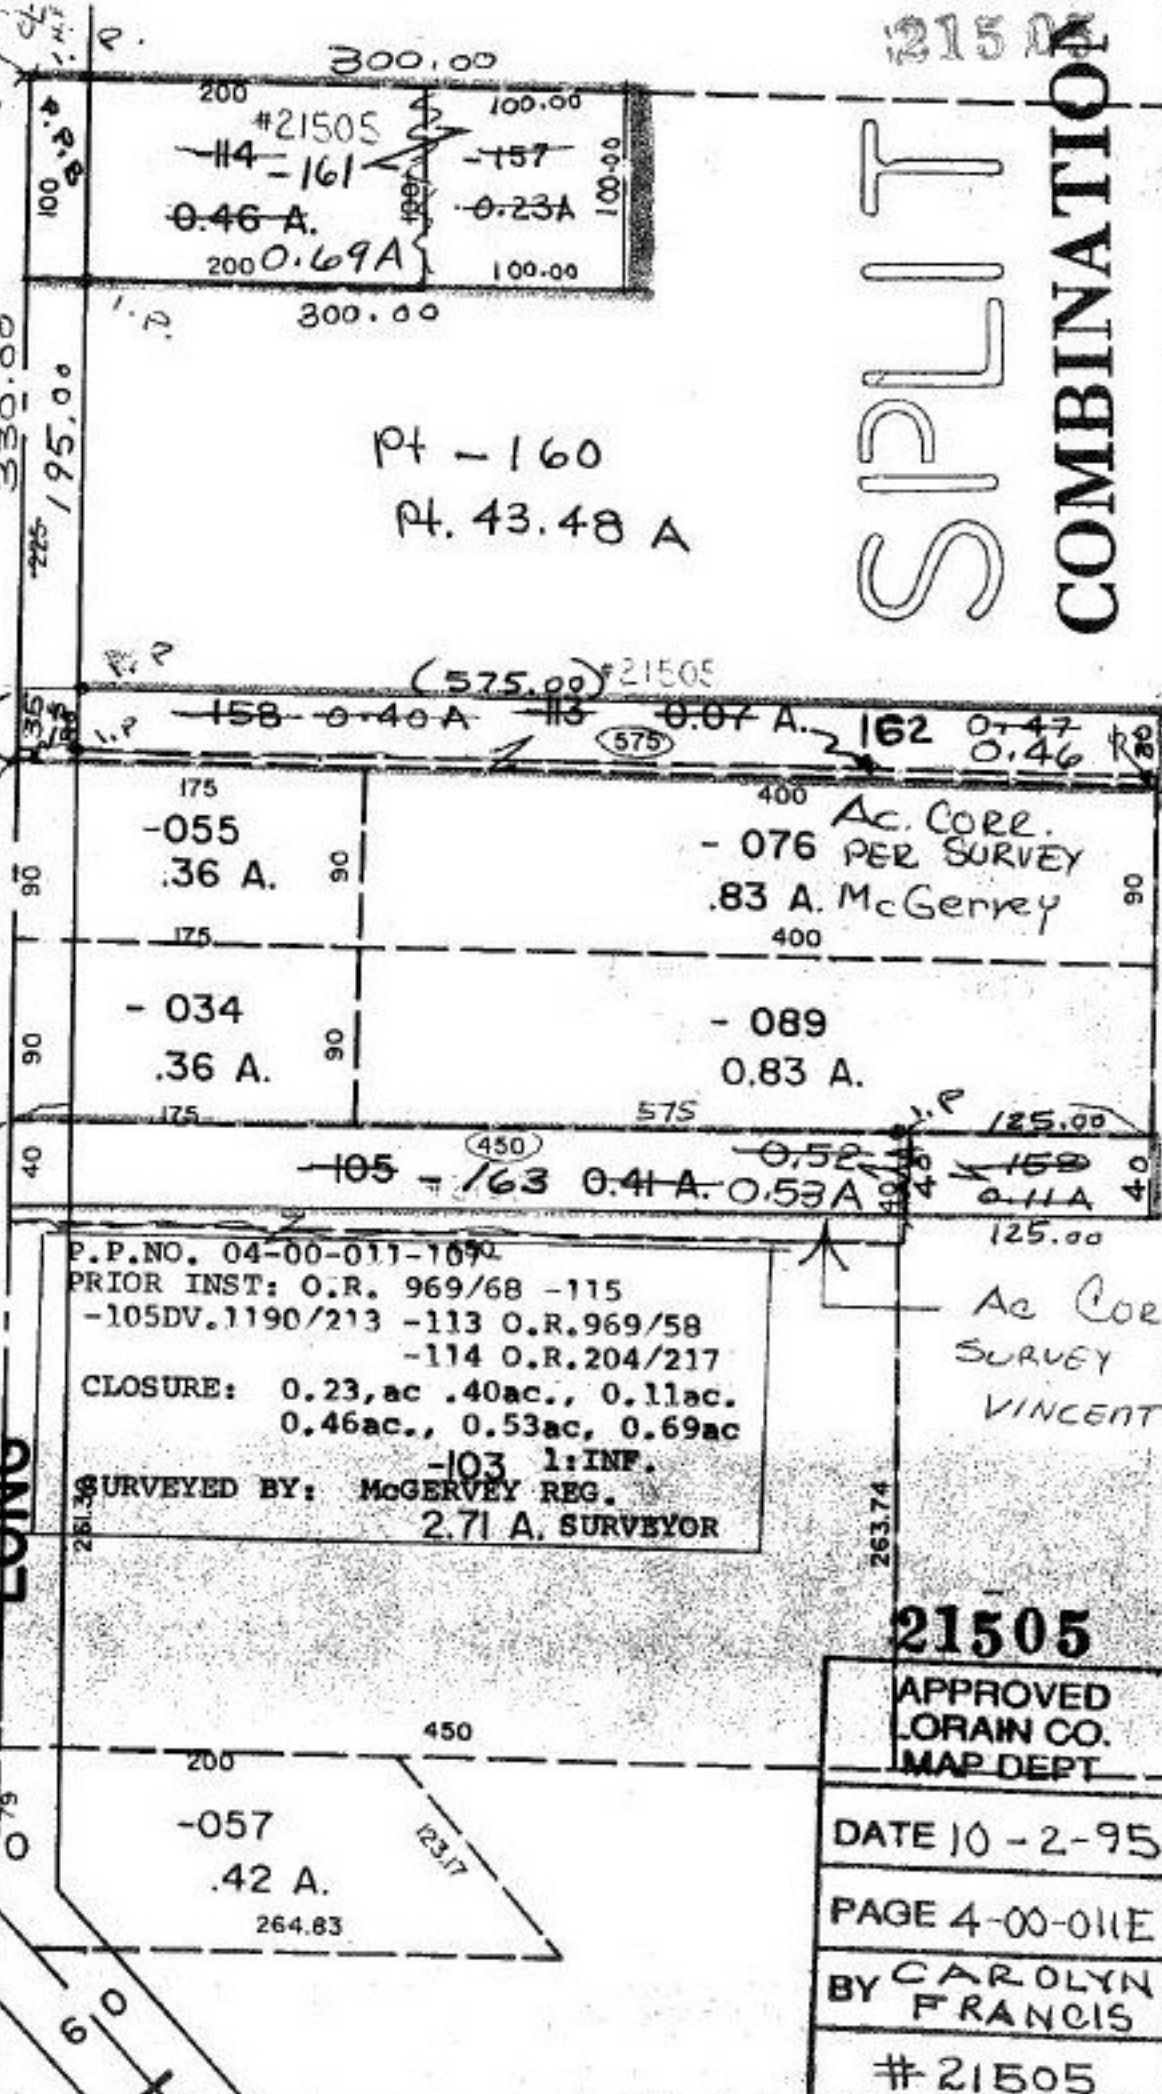

21505

SPLIT COMBINATION

21505

APPROVED
ORAIN CO.
MAP DEPT

DATE 10-2-95

PAGE 4-00-011E

BY CAROLYN
FRANCIS

#21505