


SEE 2-02-021-A

FULMER

#21506

APPROVED	
LORAIN CO. MAP DEPT.	
DATE	9-14-95
PAGE	2-03-001-B
BY	T-McM
MAP NUMBER	21506

COMBINATION

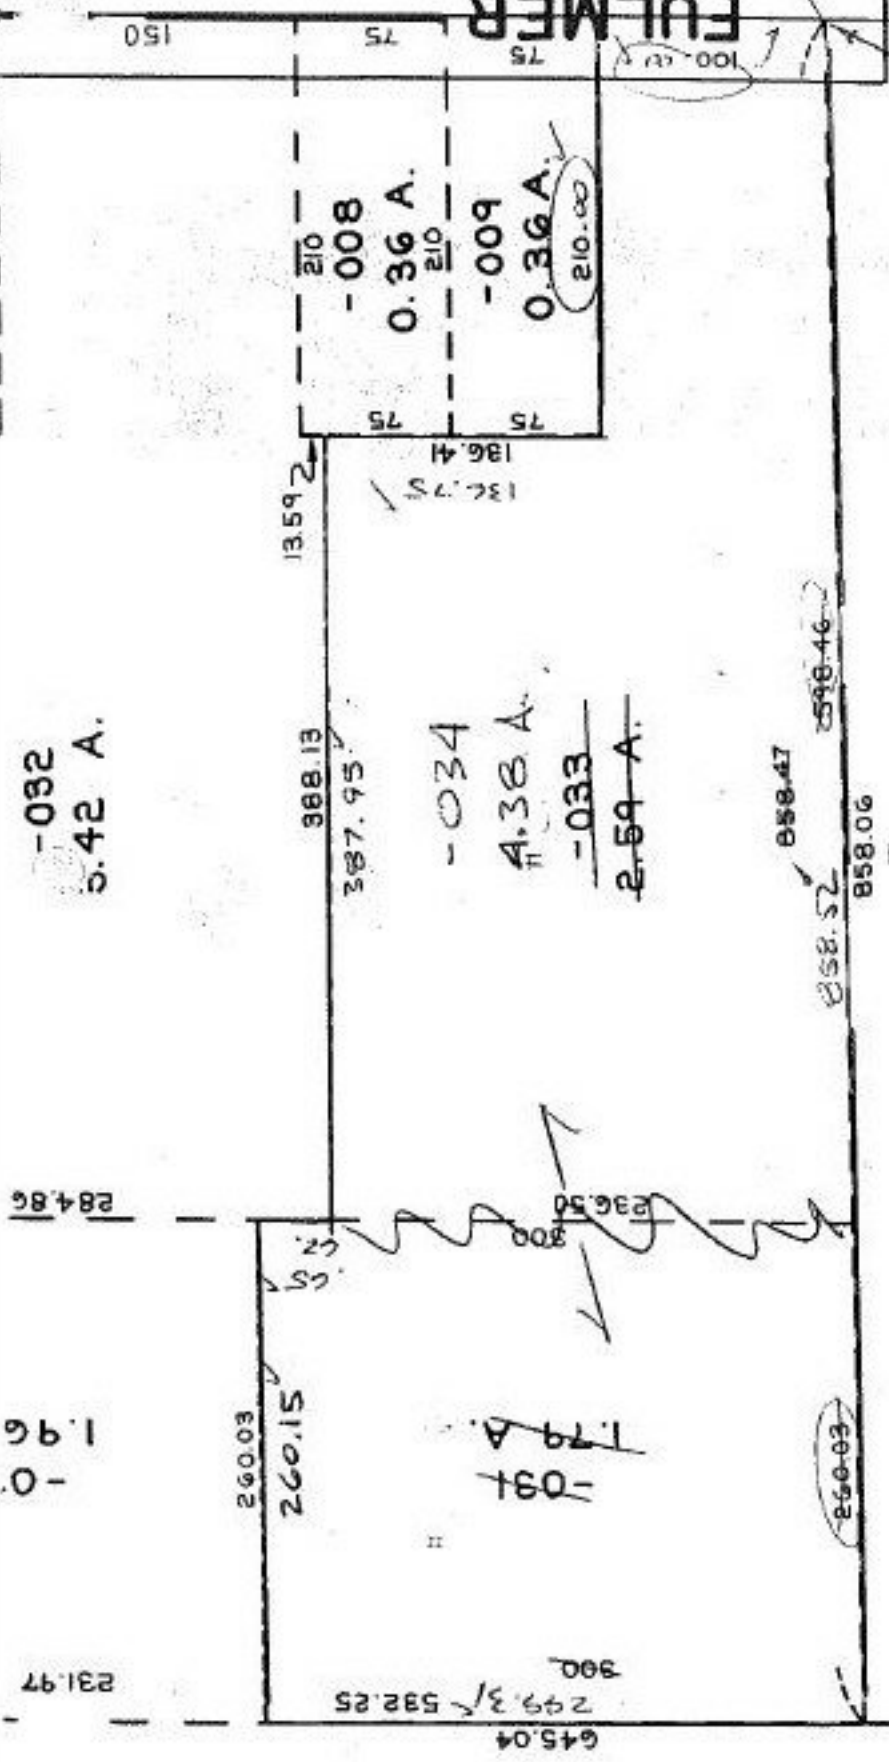

108